

YAZOO

R 2000

R 301

7-60

WATER WELL DRILLERS LOG

Date: July, 1960, Driller: J.G. Barnes Water Well County YAZOO (Name)

(1) Owner of Land: Homer Kelly (Name)	Description & Color of Materials Sand, Clay, Red Clay, Shell, etc.	Thick- ness Feet	Depth Feet.
Anding, Miss. (Address)	Clay	50	
	Sand	10	
(2) Location: SE 1/4, SW 1/4, Sec. 21 10 th R. 30 th W.	Blue Shell	280	
3 miles West, of Little Yazoo (distance) (direction) (Nearest town)	Rock	2	
(3) Topography: Hilly (Hilly) (Flat) (Level)	15 ft. water sand	15	
(4) Purpose of Well: Farm use (Domestic Irrigation Municipal, Industrial, Other)	Brown Shell	70	
	Scattered Sand & Shell	70	
	Water sand	60	

Information upon completion of well:


- (1) Diameter 2 inches.
- (2) Total Depth 550 feet.
- (3) Water Level 200 feet below top of ground.
- (4) Cased to 529, Size 2"
- (5) Screen: Size 0006, Length 20
- (6) Were any formations sealed against pollution?

yes, no.

If YES depth of formation _____

Why _____

Drillers Remarks: _____

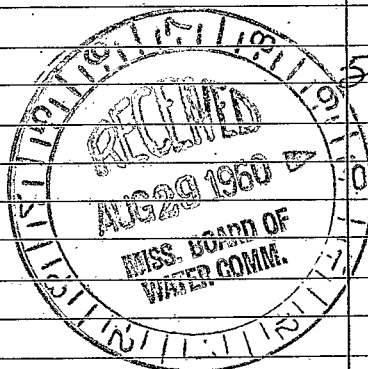

557

(Use Back Side)

Well No.

