

YAZOO

R 0003

11-29-61

WATER WELL DRILLERS LOG

R

Date: Nov 29, 1961, Driller: J. H. Barnes County Yazoo

(Name)

(1) Owner of Land: W. O. Strickland
(Name)

Yazoo Ctte. Miss.
(Address)

(2) Location: N-W 1/4, S-E 1/4, Sec. 26, T10 N, R 24 W
2 miles North, of Bentonia
(distance) (direction) (Nearest Town)

(3) Topography: Hilly
(Hills) (Flat) (Level)

(4) Purpose of Well: Farm use
(Domestic Irrigation, Municipal, Industrial, Other)

Description & Color of Materials Sand, Clay, Red Clay, Shell, etc.	Thick- ness Feet	Depth Feet
<u>yellow clay</u>	<u>100</u>	<u>60</u>
<u>sand & gravel</u>	<u>140</u>	<u>100</u>
<u>Blue Clay</u>	<u>200</u>	<u>340</u>
<u>Rock</u>	<u>1</u>	<u>341</u>
<u>muddy Branch</u>		
<u>hard shell</u>	<u>40</u>	<u>381</u>
<u>Dark Brown</u> <u>& Blue Color</u>		
<u>Clay</u>	<u>140</u>	<u>521</u>
<u>water sand</u>	<u>91</u>	<u>612</u>


Information upon completion of well:

- (1) Diameter 4" inches.
- (2) Total Depth 612 feet.
- (3) Water Level 201 feet below top of ground.
- (4) Cased to 592, Size 2"
- (5) Screen: Size 0006, Length 20
- (6) Were any formations sealed against pollution?
yes, no.

If YES depth of formation _____

Why _____

Drillers Remarks: _____

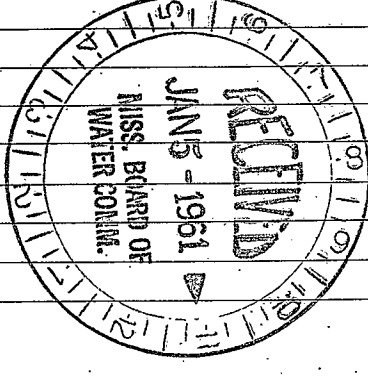

(Use Back Side)

Well No.

