

Yazoo
12-2007
7-66

WATER WELL DRILLERS LOG

Date: 7-23, 1966, Driller: Bud CRESSWELL County Yazoo
(Name)

(1) Owner of Land: Leola Allen
(Name)
BENTONIA, Miss.
(Address)

(2) Location: NE 1/4, SW 1/4, Sec. 35 T10 N R12 W
1 miles North of BENTONIA
(distance) (direction) (Nearest Town)

(3) Topography: Level
(Hilly) (Flat) (Level)

(4) Purpose of Well: Domestic
(Domestic Irrigation
Municipal, Industrial, Other)

Description & Color of Materials Sand, Clay, Red Clay, Shell, etc.	Thick- ness Feet	Depth Feet
<u>CLAY</u>	<u>40</u>	<u>40</u>
<u>SAND</u>	<u>20</u>	<u>60</u>
<u>YAZOO Clay</u>	<u>440</u>	<u>500</u>
<u>Sand</u>	<u>80</u>	<u>580</u>

Information upon completion of well:

(1) Diameter 4x2 inches.

(2) Total Depth 580 feet.

(3) Water Level 100 feet below top of ground.

(4) Cased to 315, Size 4


(5) Screen: Size 008, Length 20

(6) Were any formations sealed against pollution?
_____ yes, _____ no.

If YES depth of formation _____

Why _____

Drillers Remarks: _____

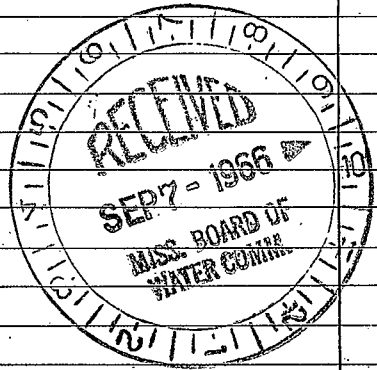

(Use Back Side)

Well No.

