

**MISSISSIPPI  
BOARD OF WATER COMMISSIONERS**  
416 North State Street  
Jackson, Mississippi 39201

**WATER WELL DRILLERS LOG**

Yazoo  
Ross  
4-67

April 1 19 67 Bud Cresswell Yazoo  
date well completed firm name county well located

**LANDOWNER:**

Mrs. Ruby WIRTH  
BENTONIA, Miss.  
(mailing address)

**description of formations encountered**

	from	to
<u>red clay</u>	<u>0</u>	<u>60</u>
<u>sand and gravel</u>	<u>60</u>	<u>120</u>
<u>Yazoo Clay</u>	<u>120</u>	<u>340</u>
<u>sandy shale</u>	<u>340</u>	<u>400</u>
<u>sand</u>	<u>400</u>	<u>480</u>

**WELL LOCATION:**

sec. 30 T. 100 N. R. 2 E.  
Oil City, Miss.  
miles of (distance) (direction) (nearest town)

**WELL PURPOSE:**


Home  
(home, irrigation, municipal, industrial)

**WELL COMPLETION DATA:**

- (1) diameter (inches) 4 x 2
- (2) total depth (feet) 480
- (3) static water level (feet) 225 below top of ground.
- (4) casing 4" 357'  
(material) (depth)  
4" if telescope see back.  
(size)
- (5) screen 30' 450'  
(length) (depth to top)  
008 55  
(size) (material)
- (6) pump: \_\_\_\_\_ (HP) \_\_\_\_\_ (yield gpm)  
(type power)
- (7) electric log No  
(yes or no)  
(organization running log)
- (8) how well bottom plugged reducer - plug

**DRILLERS REMARKS:**

480  
357  
123  
123  
123

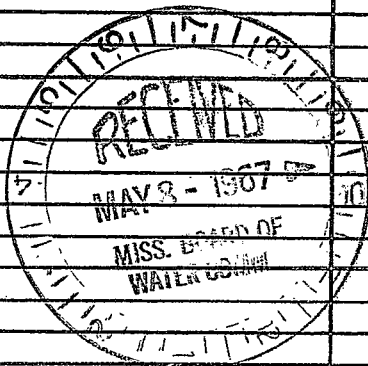

If well telescopes please sketch and show depths.

GROUND LEVEL

4"  
357'


2"  
93'

008.

30'

S.S.

If more than one screen, show locations of each on sketch.

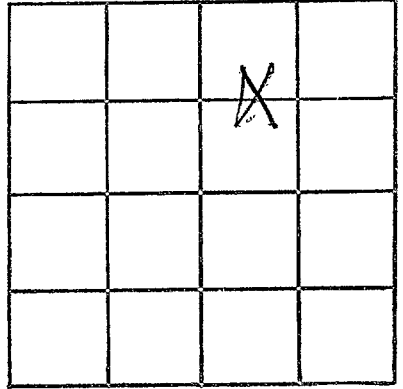

SECTION 30

Please indicate well location X.

ADDITIONAL INFORMATION

Lined area for additional information.