

Yazoo
R 2007
11-7-75

MISSISSIPPI
 BOARD OF WATER COMMISSIONERS
 416 North State Street
 Jackson, Mississippi 39201


WATER WELL DRILLERS LOG

11-7 19*75* *E.M. "Bud" Cresswell* *YA200*
 date well completed firm name county well located

LANDOWNER:	description of formations encountered	from	to
<i>Lena C. Cowan</i>			
<i>Benton</i> No. <i>39040</i> (mailing address)	<i>red clay</i>	<i>0</i>	<i>60</i>
	<i>blue clay</i>	<i>60</i>	<i>380</i>
	<i>hard shells</i>	<i>380</i>	<i>400</i>
	<i>fine sand</i>	<i>400</i>	<i>460</i>
	<i>shale</i>	<i>460</i>	<i>480</i>
	<i>sand</i>	<i>480</i>	<i>560</i>
WELL LOCATION: sec. <i>25</i> T <i>10</i> N R <i>2</i> W <i>4</i> miles <i>NE</i> of <i>BENTONIA</i> (distance) (direction) (nearest town)			
WELL PURPOSE: <i>home</i> (home, irrigation, municipal, industrial)			
WELL COMPLETION DATA:			
(1) diameter (inches) <i>2</i>			
(2) total depth (feet) <i>540</i>			
(3) static water level (feet) <i>180</i> below top of ground.			
(4) casing <i>Steel</i> , <i>520</i> , (material) (depth)			
<i>2</i> If telescope see back. (size)			
(5) screen <i>20</i> , <i>520</i> (length) (depth to top)			
<i>2</i> , <i>Stainless</i> (size) (material)			
(6) pump <i>Air Compressor</i> (HP) (yield gpm)			
<i>0</i> (type power)			
(7) electric log <i>No</i> (yes or no)			
<i>0</i> (organization running log)			
(8) how well bottom plugged <i>Steel plug</i>			
DRILLERS REMARKS:			

If well telescopes please sketch and show depths.

GROUND LEVEL

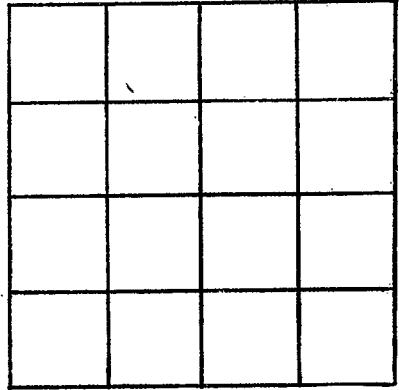

SECTION _____

Please indicate well location X.

ADDITIONAL INFORMATION

If more than one screen, show locations of each on sketch.