

YAZOO
R
5-178

MISSISSIPPI
BOARD OF WATER COMMISSIONERS
416 North State Street
Jackson, Mississippi 39201

WATER WELL DRILLERS LOG

5-1 1978 E.M. "Bud" Cresswell YAZOO
date well completed firm name county well located


LANDOWNER:	description of formations encountered	from	to
Jimmy Douglas Benton, Ms. 39040 (mailing address)			
WELL LOCATION: sec. 2 T 10 N R 2 E 4 miles North of Benton (distance) (direction) (nearest town)			
WELL PURPOSE: Home (home, irrigation, municipal, industrial)			
WELL COMPLETION DATA: (1) diameter (inches) 2 (2) total depth (feet) 70 (3) static water level (feet) 50 below top of ground (4) casing PVC 65 (material) (depth) 2 (size) if telescope see back. (5) screen 5 65 (length) (depth to top) 2 PVC (size) (material) (6) pump 1 5 (HP) (yield gpm) 0 (type power) (7) electric log No (yes or no) (organization running log)			
(8) how well bottom plugged Backwash valve			
DRILLERS REMARKS:			

RECEIVED
MAY 3 - 1978

MISS. BD. OF WATER COM.

If well telescopes please
sketch and show depths.

GROUND LEVEL

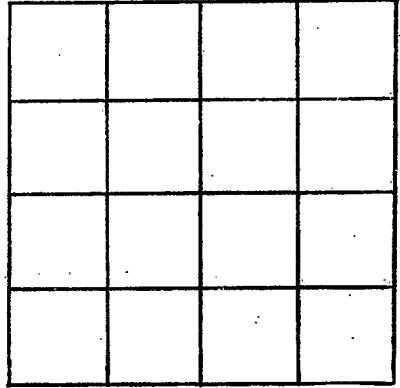

SECTION _____

Please indicate well location X.

ADDITIONAL INFORMATION

If more than one screen,
show locations of each on sketch.