

Yazoo
R 2012
1-22-80

MISSISSIPPI
 BOARD OF WATER COMMISSIONERS
 416 North State Street
 Jackson, Mississippi 39201

WATER WELL DRILLERS LOG

Jan. 22 1980 E.M. "Bud" Gresswell Yazoo
 date well completed firm name county well located

LANDOWNER:
C. C. Twister
Benton, Ms.
 (mailing address)

| description of formations encountered | from | to |
|---------------------------------------|-----------|------------|
| <u>Clay</u> | <u>0</u> | <u>65</u> |
| <u>Sand-gravel</u> | <u>60</u> | <u>110</u> |

WELL LOCATION:
 sec. 23 T. 10 N. R. 2 E.
4 miles North of Benton
 (distance) (direction) (nearest town)

WELL PURPOSE: Home
 (home, irrigation, municipal, industrial)

- WELL COMPLETION DATA:
- (1) diameter (inches) 2
 - (2) total depth (feet) 110
 - (3) static water level (feet) 85 below above top of ground.
 - (4) casing PVC 100
 (material) (depth)
2 if telescope see back.
 (size)
 - (5) screen 10 100
 (length) (depth to top)
2 PVC
 (size) (material)
 - (6) pump 1 5
 (HP) (yield gpm)
0
 (type power)
 - (7) electric log No
 (yes or no)
- (organization running log)

DEPT. OF NATURAL RESOURCES
 BUREAU OF LAND & WATER RESOURCES

(8) how well bottom plugged
Backwash valve


DRILLERS REMARKS:

FEB 25 1980

RECEIVED

If well telescopes please sketch and show depths.

GROUND LEVEL

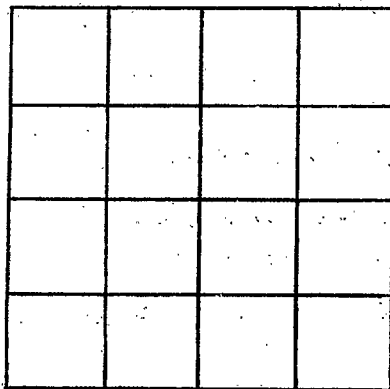

SECTION _____

Please indicate well location X.

ADDITIONAL INFORMATION

If more than one screen,
show locations of each on sketch.