

**MISSISSIPPI
BOARD OF WATER COMMISSIONERS
416 North State Street
Jackson, Mississippi 39201**

WATER WELL DRILLERS LOG

Yazoo
R 2013
5-14-80

May 14 1980 E.M. "Bud" Cresswell YA200
date well completed firm name county well located

LANDOWNER:	description of formations encountered	from	to
<u>Ed Gray</u> <u>Yazoo City, Mo. 39040</u> (mailing address)	<u>Clay</u> <u>Bank gravel</u>	<u>0</u> <u>45</u>	<u>45</u> <u>85</u>
WELL LOCATION:			
sec. <u>2</u> T. <u>10</u> N R. <u>2</u> W <u>6</u> miles <u>South</u> of <u>Yazoo</u> (distance) (direction) (nearest town)			
WELL PURPOSE: <u>Home</u> (home, irrigation, municipal, industrial)			
WELL COMPLETION DATA:			
(1) diameter (inches) <u>2</u>			
(2) total depth (feet) <u>85</u>			
(3) static water level (feet) <u>65</u> <u>below</u> top of ground. <u>above</u>			
(4) casing <u>PVC</u> <u>80</u> (material) (depth)			
<u>2</u> if telescope see back. (size)			
(5) screen <u>5</u> <u>80</u> (length) (depth to top)			
<u>2"</u> <u>PVC</u> (size) (material)			
(6) pump <u>1</u> <u>5</u> (HP) (yield gpm)			
<u>0</u> (type power)			
(7) electric log <u>no</u> (yes or no)			
(organization running log)			
(8) how well bottom plugged <u>Dark sand</u>			
DRILLERS REMARKS:			


DEPT. OF NATURAL RESOURCES
BUREAU OF LAND & WATER RESOURCES

MAY 28 1980

RECEIVED

If well telescopes please sketch and show depths.

GROUND LEVEL

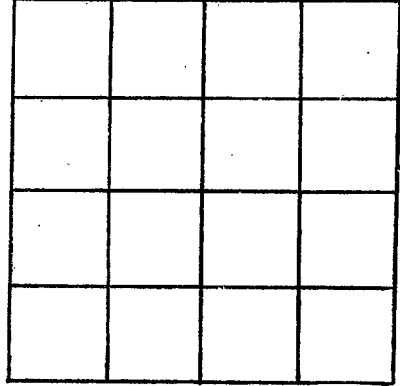

SECTION _____

Please indicate well location X.

ADDITIONAL INFORMATION

If more than one screen, show locations of each on sketch.