

MISSISSIPPI DEPARTMENT OF NATURAL RESOURCES

Bureau of Land and Water Resources

Southport Mall

P.O. Box 10631

Jackson, Mississippi 39209

WATER WELL DRILLERS LOG

YA200
R2006

Jan. 3 1984 E.M. "Bud" Cresswell YA200
 date well completed firm name county well located

LANDOWNER:	description of formations encountered	from	to
<u>Emmett Callihan</u> <u>P.O. 3, Ya200 City, MS. 39194</u> (mailing address)			
WELL LOCATION:			
sec. <u>9</u> T <u>10N</u> R <u>2E</u> W <u>3</u> (distance) miles (direction) of (nearest town)			
WELL PURPOSE: <u>Home</u> (home, irrigation, municipal, industrial)			
WELL COMPLETION DATA:			
(1) diameter (inches) <u>2</u>			
(2) total depth (feet) <u>90</u>			
(3) static water level (feet) <u>70</u> below above top of ground.			
(4) casing <u>PVC</u> <u>80</u> (material) (depth)			
<u>2</u> if telescope see back. (size)			
(5) screen <u>10</u> <u>80</u> (length) (depth to top)			
<u>2</u> <u>PVC</u> (size) (material)			
(6) pump <u>1</u> <u>5</u> (HP) (yield gpm)			
<u>0</u> (type power)			
(7) electric log <u>No</u> (yes or no)			
<u></u> (organization running log)			
(8) how well bottom plugged <u>back wash valve</u>			

DEPT. OF NATURAL RESOURCES
 BUREAU OF LAND & WATER RESOURCES


JAN 10 1984

RECEIVED

DRILLERS REMARKS:

If well telescopes please sketch and show depths.

GROUND LEVEL

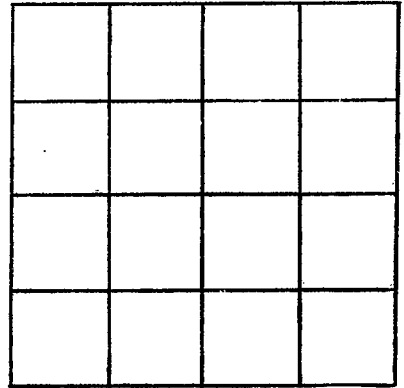

SECTION _____

Please indicate well location X.

ADDITIONAL INFORMATION

If more than one screen,
show locations of each on sketch.