

MISSISSIPPI DEPARTMENT OF NATURAL RESOURCES

Bureau of Land and Water Resources

Southport Mall

P.O. Box 10631

Jackson, Mississippi 39209

WATER WELL DRILLERS LOG

Yazoo  
R  
207

Nov. 28 1984 E.M. Bud Cresswell Yazoo  
date well completed firm name county well located

LANDOWNER:	description of formations encountered	from	to
Clara Hatchett Yazoo City, MS. (mailing address)	CLAY SAND-GRAVEL	0	40 110
WELL LOCATION: sec. 2 T 10 N R 2 W 7 miles South of Yazoo City (distance) (direction) (nearest town)			
WELL PURPOSE: Home (home, irrigation, municipal, industrial)			
WELL COMPLETION DATA:			
(1) diameter (inches) 2			
(2) total depth (feet) 710			
(3) static water level (feet) 80 below top of ground.			
(4) casing PVC, 100 (material), (depth), 2 (size) if telescope see back.			
(5) screen 10, 100 (length), (depth to top), 2 (size), PVC (material)			
(6) pump 1, 5 (HP), (yield gpm), (type power)			
(7) electric log No (yes or no), (organization running log)			
(8) how well bottom plugged Back Wash Valve			
DRILLERS REMARKS:			


DEPT. OF NATURAL RESOURCES  
BUREAU OF LAND & WATER RESOURCES

DEC - 7 1984

RECEIVED

If well telescopes please sketch and show depths.

GROUND LEVEL

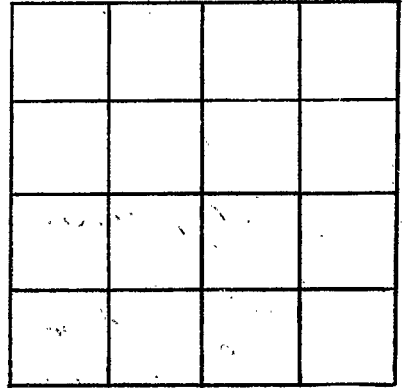

SECTION \_\_\_\_\_

Please indicate well location X.

ADDITIONAL INFORMATION

If more than one screen, show locations of each on sketch.