

Yazoo
 R 2018

Seeds
 completed

DEPARTMENT OF NATURAL RESOURCES
 Land and Water Resources
 Post Office Box 10631
 Jackson, Mississippi 39209
RILLERS LOG

Sept. 5 19

Yazoo
 county well located

firm name

LANDOWNER:	description of formations encountered	from	to
Koch Pipelines Benton, A. MS. (mailing address)	Drilled 6"		
WELL LOCATION: Sec 18 T 10 N R 2 W 2 miles SE of Tinsley (distance) (direction) (nearest town)	hole for Corrosion Protection		
WELL PURPOSE: (home, irrigation, municipal, industrial)	Surface	0	10
WELL COMPLETION DATA: (1) diameter (inches) (2) total depth (feet) (3) static water level (feet) _____ below above top of ground. (4) casing _____ (material) _____ (depth) _____ if telescope see back. (size) (5) screen _____ (length) _____ (depth to top) _____ (size) _____ (material) (6) pump _____ (HP) _____ (yield gpm) _____ (type power) (7) electric log _____ (yes or no) _____ (organization running log) (8) how well bottom plugged _____	Yazoo Clay	10	153
DRILLERS REMARKS:			


RECEIVED

SEP 20 1988

Department of Natural Resources
 Bureau of Land & Water Resources

If well telescopes please
sketch and show depths.

GROUND LEVEL

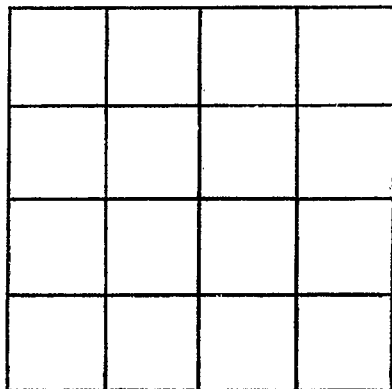

SECTION _____

Please indicate well location X.

ADDITIONAL INFORMATION

If more than one screen,
show locations of each on sketch.