

CODED

MISSISSIPPI  
BOARD OF WATER COMMISSIONERS  
416 North State Street  
Jackson, Mississippi 39201

CODED


WATER WELL DRILLERS LOG

YA200
S11
9-10-68

9 - 10 1968 Bud Cresswell Yazoo  
 date well completed firm name county well located


LANDOWNER:	description of formations encountered	from	to
Phillip Thomas Benton, Miss.  (mailing address)			
WELL LOCATION: sec <u>18</u> T <u>10</u> N R <u>1</u> E <u>20</u> <u>5</u> 10 miles south of Benton (distance) (direction) (nearest town)			
WELL PURPOSE: domestic (home, irrigation, municipal, industrial)			
WELL COMPLETION DATA:			
(1) diameter (inches) <u>2</u>			
(2) total depth (feet) <u>440</u>			
(3) static water level (feet) <u>80</u> below top of ground.			
(4) casing <u>Galv. pipe</u> (material) (depth) <u>2</u> (size) if telescope see back.			
(5) screen <u>20</u> , <u>420</u> (length) (depth to top) <u>008</u> , stainless (size) (material)			
(6) pump <u>Air Compressor</u> (HP) (yield gpm)  (type power)			
(7) electric log _____ (yes or no)  (organization running log)			
(8) how well bottom plugged _____			
DRILLERS REMARKS:			

CODED

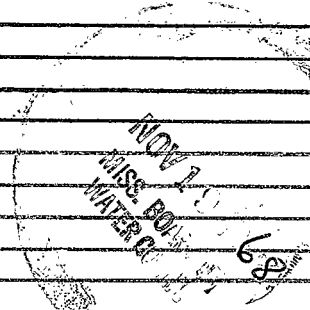

If well telescopes please sketch and show depths.

GROUND LEVEL

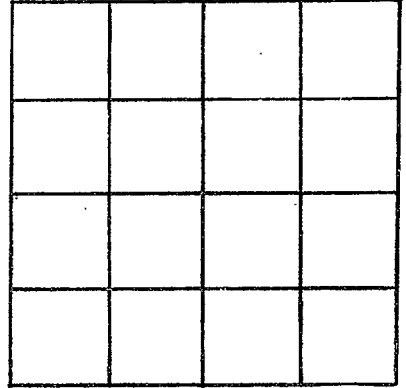

SECTION \_\_\_\_\_

Please indicate well location X.

ADDITIONAL INFORMATION

If more than one screen, show locations of each on sketch.