

dm 5/21/70

Yazoo
S13
5-15-70

MISSISSIPPI
BOARD OF WATER COMMISSIONERS
416 North State Street
Jackson, Mississippi 39201

COPIED

WATER WELL DRILLERS LOG

May 15 1970 Boyd Cassidell Yazoo
date well completed firm name county well located

LANDOWNER:
Larry Perry
Benton, Miss -
(mailing address)

description of formations encountered	from	to
	<u>Clay</u>	<u>0</u>
<u>Sand - gravel</u>	<u>35</u>	<u>89</u>

WELL LOCATION:
sec. 7 T. 10 N. R. 1 E.
5 miles N. E. of Little Yazoo
(distance) (direction) (nearest town)

WELL PURPOSE: Domestic
(home, irrigation, municipal, industrial)

WELL COMPLETION DATA:

(1) diameter (inches) 2

(2) total depth (feet) 89

(3) static water level (feet) 80 below top of ground.

(4) casing galv. 84
(material) (depth)

2 if telescope see back.
(size)

(5) screen 5 84
(length) (depth to top)

2 Standard
(size) (material)

(6) pump 3/4 5 Est
(HP) (yield gpm)

(type power)

(7) electric log NO
(yes or no)

(organization running log)

(8) how well bottom plugged pipe plug


COPIED

MAY 21 1970

DRILLERS REMARKS:

If well telescopes please sketch and show depths.

GROUND LEVEL

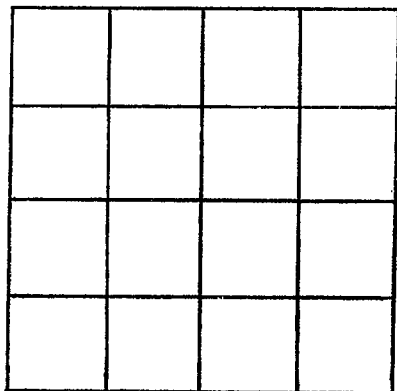

SECTION _____

Please indicate well location X.

ADDITIONAL INFORMATION

If more than one screen, show locations of each on sketch.