

YAZOO
S14
9-29-70

MISSISSIPPI
BOARD OF WATER COMMISSIONERS
416 North State Street
Jackson, Mississippi 39201

CODED

WATER WELL DRILLERS LOG

Sept. 29 1970 E.M. "Bud" Cresswell YAZOO
date well completed firm name county well located

LANDOWNER:
Gerald Ketchum
Benton, Miss.
(mailing address)

description of formations encountered	from	to
	Clay	0
sand-gravel	30	75

WELL LOCATION:
sec. 31 T. 10 N R. 1 E
6 miles South of Benton
(distance) (direction) (nearest town)

WELL PURPOSE: Domestic
(home, irrigation, municipal, industrial)

WELL COMPLETION DATA:

(1) diameter (inches) 2

(2) total depth (feet) 75

(3) static water level (feet) 60 below top of ground.

(4) casing Steel 70 (material) (depth)
2" (size) If telescope see back.

(5) screen 5 ft. 70 (length) (depth to top)
2" (size) stainless (material)

(6) pump 3/4 5 (HP) (yield gpm)
0 (type power)

(7) electric log No (yes or no)
0 (organization running log)

CODED

OCT 22 1970


(8) how well bottom plugged
Steel plug

DRILLERS REMARKS:

MISS. BD. OF
WATER COMM.

If well telescopes please sketch and show depths.

GROUND LEVEL

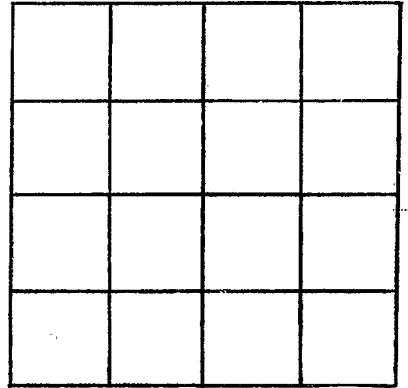

SECTION _____

Please indicate well location X.

ADDITIONAL INFORMATION

If more than one screen,
show locations of each on sketch.