

YAZOO

S15

1-6-71

MISSISSIPPI
 BOARD OF WATER COMMISSIONERS
 416 North State Street
 Jackson, Mississippi 39201

CODED

WATER WELL DRILLERS LOG

Jan 6
date well completed

1971 E.M. "Bud" Cresswell
firm name

Yazoo County
county well located

LANDOWNER:

Guy Peel
Myrtleville Road
BENTONIA, Miss.
(mailing address)

description of formations encountered

from

to

Clay - yellow	0	30
Clay - Blue	30	320
Sand shale	320	420
Sand	420	500

WELL LOCATION:

sec. 15 T 10 N R 1 W
5 miles South of BENTONIA
(distance) (direction) (nearest town)

WELL PURPOSE: Domestic
(home, irrigation, municipal, industrial)

WELL COMPLETION DATA:

- (1) diameter (inches) 2
- (2) total depth (feet) 500
- (3) static water level (feet) 120 below top of ground. above
- (4) casing galv 480
(material) (depth)
2 If telescope see back.
(size)
- (5) screen 20 480
(length) (depth to top)
2 stainless
(size) (material)
- (6) pump air compressor
(HP) (yield gpm)
0
(type power)
- (7) electric log No
(yes or no)
0
(organization running log)

CODED

(8) how well bottom plugged

steel plug


JAN 11 1971

DRILLERS REMARKS:

ENCL. BY: OF
WATER COMM.

If well telescopes please sketch and show depths.

GROUND LEVEL

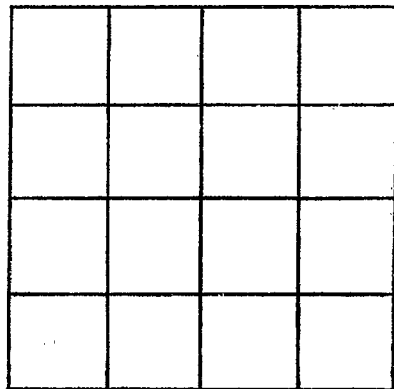

SECTION _____

Please indicate well location X.

ADDITIONAL INFORMATION

If more than one screen,
show locations of each on sketch.