

YAZOO

S17

9-10-62

WATER WELL DRILLERS LOG

CODED

Date: SEPT. 10, 1962, Driller: BUD CRESSWELL County: YAZOO

1844 4753

(Name)

(1) Owner of Land: W. G. REEVES
 (Name)
YAZOO CITY, MISS.
 (Address)

(2) Location: 1/4, 1/4, Sec. 3 T10 R1W
5 miles N-E of BENTON
 (distance) (direction) (Nearest Town)

(3) Topography: Hilly
 (Hilly) (Flat) (Level)

(4) Purpose of Well: DOMESTIC
 (Domestic Irrigation
 Municipal, Industrial, Other)

| Description & Color of Materials Sand, Clay, Red Clay, Shell, etc. | Thick- ness Feet | Depth Feet |
|---|------------------------|---------------|
| <u>YELLOW CLAY</u> | <u>80</u> | <u>80</u> |
| <u>YAZOO CLAY</u> | <u>220</u> | <u>300</u> |
| <u>GREENISH SAND</u> | <u>50</u> | <u>350</u> |
| <u>GRAVEL SDY SHALE</u> <u>with some ooze</u> | | |
| <u>sand</u> | <u>300</u> | <u>650</u> |
| <u>BROWN SHALE</u> | | |
| <u>STK S. FINE</u> | | |
| <u>SAND</u> | <u>618</u> | <u>1268</u> |
| <u>SAND</u> | <u>442</u> | <u>1310</u> |

Information upon completion of well:

(1) Diameter 4 inches.

(2) Total Depth 1310 feet.

(3) Water Level 100 feet below top of ground.
1285'

(4) Cased to 720, Size _____


(5) Screen: Size 2", Length 25'

(6) Were any formations sealed against pollution?
 _____ yes, no.


If YES depth of formation _____

Why _____

Drillers Remarks: _____

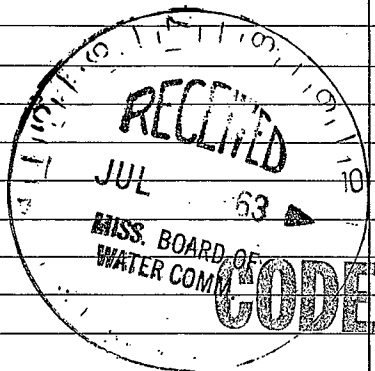

CODED

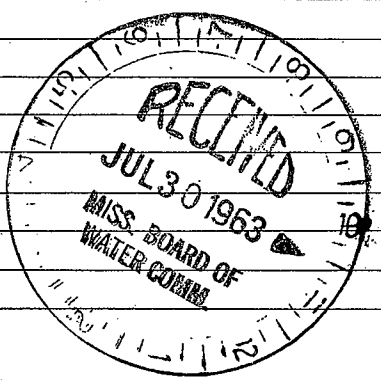

(Use Back Side)

Well No.

1947
MAY 11 1947
U.S. AIR FORCE
COMMUNICATIONS CENTER
WASH. D.C.