

YA200  
S18  
5-28-63

WATER WELL DRILLERS LOG


CODED

Date: 5-28, 1963, Driller: CHUCK C. BRIDGES County: YA200  
4847

(1) Owner of Land: CHUCK BRIDGES Logon  
(Name)  
DETONVILLE MISS  
(Address)  
(2) Location: 1/4, 1/4, Sec. 25 T10 R1W  
6 miles EAST of DETONVILLE  
(distance) (direction) (Nearest Town)  
(3) Topography: FLAT (Level)  
(Hilly) (Flat)  
(4) Purpose of Well: DOMESTIC  
(Domestic Irrigation Municipal, Industrial, Other)

Description & Color of Materials Sand, Clay, Red Clay, Shell, etc.	Thick- ness Feet	Depth Feet
<u>SURFACE</u>	<u>2</u>	<u>2</u>
<u>SAND</u>	<u>17</u>	<u>19</u>

CODED

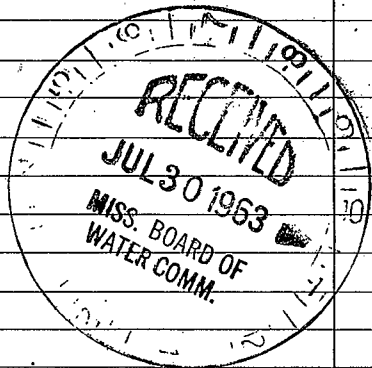

Information upon completion of well:

(1) Diameter 2 inches.  
(2) Total Depth 47 feet.  
(3) Water Level 10 feet below top of ground.  
(4) Cased to 47, Size \_\_\_\_\_  
(5) Screen: Size 2", Length 5'  
(6) Were any formations sealed against pollution?  
\_\_\_\_\_ yes, \_\_\_\_\_ no.

If YES depth of formation \_\_\_\_\_

Why \_\_\_\_\_

Drillers Remarks: \_\_\_\_\_

Well No.

(Use Back Side)

