

YA200
 OS 19
 10-63

MISSISSIPPI BOARD OF WATER COMMISSIONERS

WATER WELL DRILLERS LOG

CODED

Date: Oct., 1963, Driller: David Benny County Greene
 9790 (Name)

(1) Owner of Land: J. M. Tyen
 (Name)
Benton, Miss.
 (Address)

(2) Location: 1/4, 1/4, Sec. 9 T10R1W
9 miles SW of Benton
 (distance) (direction) (Nearest Town)

(3) Topography: Hilly
 (Hilly) (Flat) (Level)

(4) Purpose of Well: Domestic
 (Domestic Irrigation
 Municipal, Industrial, Other)

Description & Color of Materials Sand, Clay, Red Clay, Shell, etc.	Thick- ness Feet	Depth Feet
<u>Clay</u>	<u>298</u>	<u>298</u>
<u>Break layers of rock</u>	<u>2</u>	<u>300</u>
<u>Clay</u>	<u>58</u>	<u>358</u>
<u>Break layers of rock</u>	<u>2</u>	<u>360</u>
<u>Clay</u>	<u>80</u>	<u>440</u>

Information upon completion of well:

(1) Diameter 2 inches.

(2) Total Depth 510 feet.

(3) Water Level 125 feet below top of ground.

(4) Cased to 510, Size 2

(5) Screen: Size 2, Length 10


(6) Were any formations sealed against pollution?
 _____ yes, _____ no.

If YES depth of formation _____

Why _____

Drillers Remarks: _____

CODED

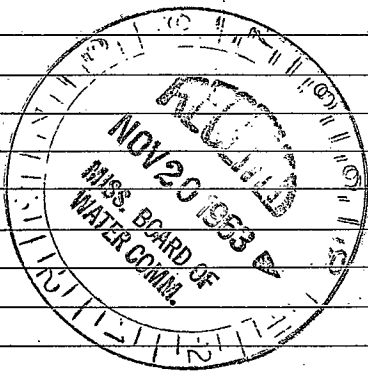

Well No.

(Use Back Side)

