

VAZOO

Date: ~~4-1-66~~ 5-20-1966, Driller: Coel - Creswell Co.

4-1-66

4757

(Name)

CODED

(1) Owner of Land: J. G. Walker
(Name)

Benton, Miss
(Address)

(2) Location: 1/4, 1/4, Sec. 3 T10R1W
10 miles S-E, of Yazoo
(distance) (direction) (Nearest Town)

(3) Topography: Hilly
(Hilly) (Flat) (Level)

(4) Purpose of Well: Domestic
(Domestic Irrigation
Municipal, Industrial, Other)

Description & Color of Materials Sand, Clay, Red Clay, Shell, etc.	Thick- ness Feet	Depth Feet
<u>Clay</u>	<u>40</u>	<u>40</u>
<u>ford</u>	<u>20</u>	<u>60</u>
<u>blue clay</u>	<u>340</u>	<u>400</u>
<u>gray shale</u>	<u>100</u>	<u>500</u>

Information upon completion of well:

(1) Diameter 4 1/2 inches.

(2) Total Depth 560 feet.

(3) Water Level 200 feet below top of ground.

(4) Cased to _____, Size _____

(5) Screen: Size _____, Length _____


(6) Were any formations sealed against pollution?
_____ yes, _____ no.

If YES depth of formation _____

Why _____

Drillers Remarks: _____

CODED

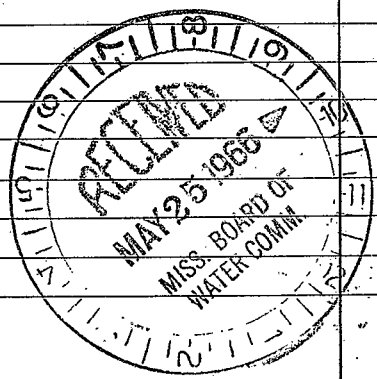

(Use Back Side)

Well No.

