

MISSISSIPPI DEPARTMENT OF NATURAL RESOURCES

Bureau of Land and Water Resources

Southport Mall

P.O. Box 10631

Jackson, Mississippi 39209

WATER WELL DRILLERS LOG

Yazoo
523

JAN. 20 1987 ST E. M. Bud Gesswell Yazoo
 date well completed firm name county well located

LANDOWNER:
B.G. Fortenberry Delq. Co.
Natchez, Ms.
 (mailing address)

description of formations encountered	from	to
Surface	0	10
river sand	10	30
Yazoo Clay -	30	120
Woodin Branch	120	150
shale	150	220
Rank-fine	220	240
shale	240	260
sand	260	340

WELL LOCATION:
 sec. 4 T. 10 N R. 1 E
6 miles EAST of Deatonville
 (distance) (direction) (nearest town)

WELL PURPOSE: Industrial
 (home, irrigation, municipal, industrial)

- WELL COMPLETION DATA:
- (1) diameter (inches) 3
 - (2) total depth (feet) 340
 - (3) static water level (feet) 80 below top of ground.
 - (4) casing Steel 320
 (material) (depth)
3 if telescope see back.
 (size)
 - (5) screen 20 320
 (length) (depth to top)
3 STAINLESS
 (size) (material)
 - (6) pump AIR 60
 (HP) (yield gpm)
 (type power)
 - (7) electric log NO
 (yes or no)
 (organization running log)
 - (8) how well bottom plugged
Chopped Plug

DRILLERS REMARKS:


RECEIVED

JAN 23 1987

Department of Natural Resources
 Bureau of Land & Water Resources

If well telescopes please
sketch and show depths.

GROUND LEVEL

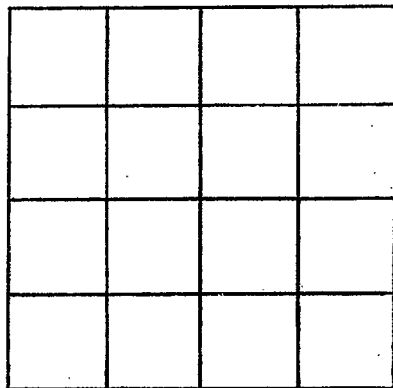

SECTION _____

Please indicate well location X.

ADDITIONAL INFORMATION

If more than one screen,
show locations of each on sketch.