

YAZOO
 81-2031
 8-3-77

MISSISSIPPI
 BOARD OF WATER COMMISSIONERS
 416 North State Street
 15K Jackson, Mississippi 39201

WATER WELL DRILLERS LOG

Aug. 3 1977 E.M. "Bud" Cresswell YAZOO
 date well completed firm name county well located


LANDOWNER:	description of formations encountered	from	to
Robert Ledlow			
BENTONIA, MS. (mailing address)	Clay sand/gravel	0 50	50 75
WELL LOCATION:			
sec. 5-10 N R-1 E 6 miles North of BENTONIA (distance) (direction) (nearest town)			
WELL PURPOSE: home (home, irrigation, municipal, industrial)			
WELL COMPLETION DATA:			
(1) diameter (inches) 2			
(2) total depth (feet) 75			
(3) static water level (feet) 55 below top of ground.			
(4) casing PVC 70 (material) (depth)			
2 (size) If telescope see back.			
(5) screen 5 70 (length) (depth to top)			
2 PVC (size) (material)			
(6) pump 1 10 (HP) (yield gpm)			
(type power)			
(7) electric log No (yes or no)			
0 (organization running log)			
(8) how well bottom plugged			
Steel plug			
DRILLERS REMARKS:			

RECEIVED
 AUG 12 1977

MISS. BD. OF WATER COMM.

If well telescopes please sketch and show depths.

GROUND LEVEL

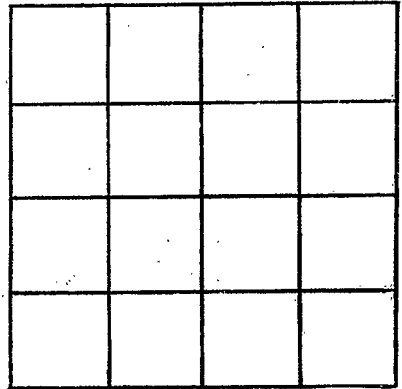

SECTION _____

Please indicate well location X.

ADDITIONAL INFORMATION

If more than one screen,
show locations of each on sketch.