

MISSISSIPPI
BOARD OF WATER COMMISSIONERS
416 North State Street
Jackson, Mississippi 39201

CODED

CODED

WATER WELL DRILLERS LOG

YAZOO
T-7
15-24-71

May 24 1971
date well completed

JOHN A. DAVIS
firm name

Yazoo
county well located

LANDOWNER: <u>Dick Dixon</u> <u>Rt. 1</u> <u>Benton, Miss</u> (mailing address)	description of formations encountered	from	to
WELL LOCATION: sec. <u>3</u> T- <u>10</u> N R- <u>1</u> E <u>1 1/2</u> miles <u>E</u> of <u>Fayette</u> (distance) (direction) (nearest town)	Red clay Brown clay Blue clay Mudstone Blue clay Sand bricks, fine Sand gravel	0 30 80 120 142 190 325	30 80 120 142 190 325 410
WELL PURPOSE: (home, irrigation, municipal, industrial)			
WELL COMPLETION DATA:			
(1) diameter (inches) <u>2"</u>			
(2) total depth (feet) <u>410</u>			
(3) static water level (feet) <u>90</u> below above top of ground.			
(4) casing <u>Steel</u> <u>400</u> (material) (depth) <u>2"</u> (size) if telescope see back.			
(5) screen <u>10</u> <u>400</u> (length) (depth to top) <u>2"</u> <u>55</u> (size) (material)			
(6) pump <u>3</u> <u>20</u> (HP) (yield gpm) <u>Air</u> (type power)			
(7) electric log <u>No</u> (yes or no)			
(organization running log)			
(8) how well bottom plugged <u>Pin</u>			
DRILLERS REMARKS:			


CODED
CODED

AUG 5 - 1971

MISS. BD. OF
WATER COMM.

If well telescopes please sketch and show depths.

GROUND LEVEL

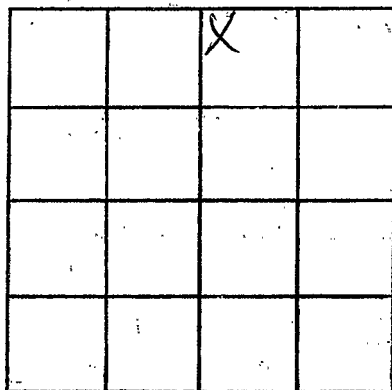

SECTION 3

Please indicate well location X.

ADDITIONAL INFORMATION

If more than one screen,
show locations of each on sketch.