

YAZOO  
T-8  
7-18-71

**CODED**

MISSISSIPPI  
BOARD OF WATER COMMISSIONERS  
416 North State Street  
Jackson, Mississippi 39201

**CODED**

**WATER WELL DRILLERS LOG**

July 18 1971 E.M. Bud Russell Yazoo  
date well completed firm name county well located

LANDOWNER:  
Mrs. W.E. Russell  
Yazoo City, Miss.  
(mailing address)

description of formations encountered	from	to
	Clay Sand	0 18

WELL LOCATION:  
sec 21 T 10 N R 1 E  
10 miles SE of Boston  
(distance) (direction) (nearest town)

WELL PURPOSE: Domestic  
(home, irrigation, municipal, industrial)

- WELL COMPLETION DATA:
- (1) diameter (inches) 2
  - (2) total depth (feet) 30
  - (3) static water level (feet) 25 below top of ground
  - (4) casing Steel 25 (material) (depth)  
2 (size) if telescope see back.
  - (5) screen 5 25 (length) (depth to top)  
2 (size) Stainless (material)
  - (6) pump None 0 (HP) (yield gpm)  
0 (type power)
  - (7) electric log 0 (yes or no)  
0  
(organization running log)

**CODED**

(8) how well bottom plugged  
Steel plug


DRILLERS REMARKS:

AUG 18 1971

MISS. BD. OF  
WATER COMM.

If well telescopes please sketch and show depths.

GROUND LEVEL

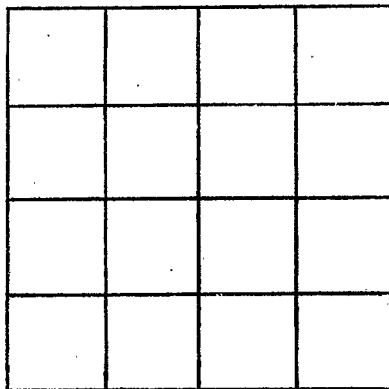

SECTION \_\_\_\_\_

Please indicate well location X.

ADDITIONAL INFORMATION

If more than one screen, show locations of each on sketch.