

YAZOO
T 12
1-14-75

MISSISSIPPI
BOARD OF WATER COMMISSIONERS
416 North State Street
Jackson, Mississippi 39201

WATER WELL DRILLERS LOG **CODED**

Jan 14 1975 R.M. "Bud" CRESSWELL YAZOO
date well completed firm name county well located


LANDOWNER:	description of formations encountered	from	to
DON SALINA BENTON, Miss. (mailing address)	Clay Sandy Shale Sand	0 180 340	18 1/2 340 440
WELL LOCATION: sec. <u>20</u> T <u>10</u> N R <u>1</u> E <u>5</u> miles <u>E</u> of <u>BENTON</u> (distance) (direction) (nearest town)			
WELL PURPOSE: <u>Home</u> (home, irrigation, municipal, industrial)			
WELL COMPLETION DATA:			
(1) diameter (inches) <u>2</u>			
(2) total depth (feet) <u>440</u>			
(3) static water level (feet) <u>120</u> below above top of ground.			
(4) casing <u>Steel</u> , <u>420</u> , (material) (depth)			
<u>2</u> if telescope see back. (size)			
(5) screen <u>20</u> <u>420</u> (length) (depth to top)			
<u>2</u> <u>Stainless</u> (size) (material)			
(6) pump <u>air Compressor</u> (HP) (yield gpm)			
<u>0</u> (type power)			
(7) electric log <u>No</u> (yes or no)			
<u>0</u> (organization running log)			
(8) how well bottom plugged			
<u>Steel plug</u>			
DRILLERS REMARKS:			

RECEIVED
FEB 6 1975

MISS. BD. OF WATER COMMISSIONERS

If well telescopes please
sketch and show depths.

GROUND LEVEL

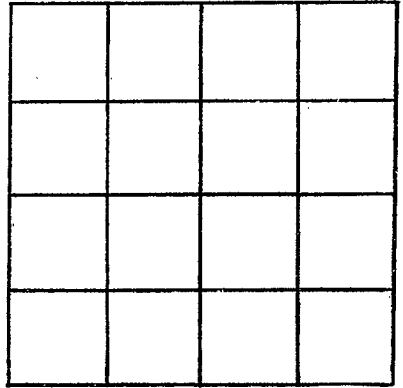

SECTION _____

Please indicate well location X.

ADDITIONAL INFORMATION

If more than one screen,
show locations of each on sketch.