

Yanoo
 T113
 10/19/77

MISSISSIPPI
 BOARD OF WATER COMMISSIONERS
 416 North State Street
 Jackson, Mississippi 39201

CODED

WATER WELL DRILLERS LOG

10/19/77 date well completed 19 Gruber Drilling Service firm name Yanoo county well located

LANDOWNER: Louisiana
 Land Exploration
 C.W. Led better
 (mailing address)

description of formations encountered	from	to
Clay	0	21
Clay	21	42
Stratified	42	63
Rock + Clay	63	84
Clay	84	105
Clay	106	168
Sand	169	231
Stratified	232	273
Sand	273	357
Stratified	357	378

WELL LOCATION:
 1590' N + 1334' E of SW/Cor
 sec. 1 T 10 N R 1 E
 S W
 6 miles SE of Pontotoc
 (distance) (direction) (nearest town)

WELL PURPOSE:
 (home, irrigation, municipal, industrial)

WELL COMPLETION DATA:

(1) diameter (inches) 3"
 (2) total depth (feet) 378
 (3) static water level (feet) 25' below top of ground
 (4) casing Steel 347' (material) (depth)
 (size) if telescope see back.
 (5) screen 42' 305' (length) (depth to top)
 3" Perforated Pipe (size) (material)
 (6) pump 70 (HP) (yield gpm)
 AC (type power)
 (7) electric log NO (yes or no)
 (organization running log)

(8) how well bottom plugged orange
 Peel

DRILLERS REMARKS:
 Dandy Lead

CODED


RECEIVED

NOV 25 1977

MISS. Bd. OF WATER COMM.

If well telescopes please sketch and show depths.

GROUND LEVEL

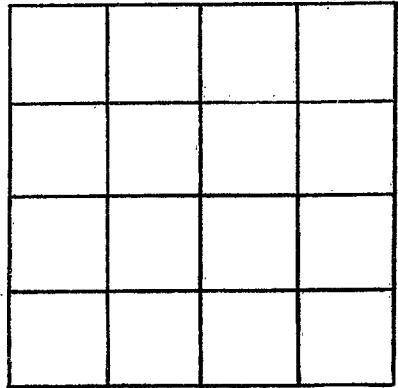

SECTION _____

Please indicate well location X.

ADDITIONAL INFORMATION

If more than one screen, show locations of each on sketch.