

MISSISSIPPI DEPARTMENT OF NATURAL RESOURCES

Bureau of Land and Water Resources

Southport Mall

P.O. Box 10631

Jackson, Mississippi 39209

WATER WELL DRILLERS LOG

CODED

P-30 T11
 Yazoo Co.
 12-4-84

Dec. 4 1984 E.M. Bud Cresswell Madison
 date well completed firm name county well located

LANDOWNER:	description of formations encountered	from	to
<u>Theo Costas</u> <u>Canton, Miss.</u> (mailing address)			
	<u>SAND</u>	<u>15</u>	<u>40</u>
WELL LOCATION:			
sec. <u>2</u> T <u>10</u> N R <u>2</u> E			
<u>6</u> miles <u>N.W.</u> of <u>Canton</u> (distance) (direction) (nearest town)			
WELL PURPOSE: <u>Irrigation</u> (home, irrigation, municipal, industrial)			
WELL COMPLETION DATA:			
(1) diameter (inches) <u>6</u>			
(2) total depth (feet) <u>40</u>			
(3) static water level (feet) <u>18</u> below top of ground.			
(4) casing <u>PVC</u> , <u>30</u> (material) (depth)			
<u>6</u> if telescope see back. (size)			
(5) screen <u>10</u> , <u>30</u> (length) (depth to top)			
<u>6</u> , <u>Stainless</u> (size) (material)			
(6) pump <u>3</u> , <u>100</u> (HP) (yield gpm)			
(type power)			
(7) electric log <u>No</u> (yes or no)			
(organization running log)			
(8) how well bottom plugged <u>Clay</u>			
DRILLERS REMARKS:			

CODED

DEPT. OF NATURAL RESOURCES
 BUREAU OF LAND & WATER RESOURCES


DEC - 7 1984

RECEIVED

0

If well telescopes please sketch and show depths.

GROUND LEVEL

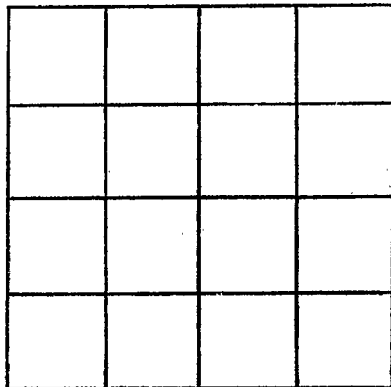

SECTION _____

Please indicate well location X.

ADDITIONAL INFORMATION

If more than one screen, show locations of each on sketch.