

MISSISSIPPI DEPARTMENT OF NATURAL RESOURCES

Bureau of Land and Water Resources

Southport Mall

P.O. Box 10631

Jackson, Mississippi 39209

WATER WELL DRILLERS LOG

CODED

VAZ00
T18
7-30-85

July 30 1985 F.M. Sed Cresswell VA200  
 date well completed firm name county well located

LANDOWNER:	description of formations encountered	from	to
Bob Mahaffey CANTON, MS. (mailing address)			
	Clay	0	80
	SAND	80	115

WELL LOCATION:  
 sec. 20 T. 10 N R. 2 E  
4 miles West of Canton  
 (distance) (direction) (nearest town)

WELL PURPOSE: Camp  
 (home, irrigation, municipal, industrial)

WELL COMPLETION DATA:

(1) diameter (inches) 4

(2) total depth (feet) 115

(3) static water level (feet) 5 below top of ground.

(4) casing PVC 95'  
 (material) (depth)  
4 if telescope see back.  
 (size)

(5) screen 20 95  
 (length) (depth to top)  
4 PVC  
 (size) (material)

(6) pump 3/4 15  
 (HP) (yield gpm)

(type power)

(7) electric log yes  
 (yes or no)  
state  
 (organization running log)

(8) how well bottom plugged  
back work

DRILLERS REMARKS:


CODED

RECEIVED  
 AUG 1 1985

Department of Natural Resources  
 Bureau of Land & Water Resources

If well telescopes please sketch and show depths.

GROUND LEVEL

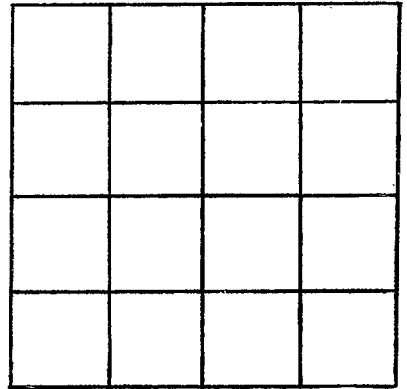

SECTION \_\_\_\_\_

Please indicate well location X.

ADDITIONAL INFORMATION

If more than one screen, show locations of each on sketch.