

MISSISSIPPI DEPARTMENT OF NATURAL RESOURCES

Bureau of Land and Water Resources

Southport Mall

P.O. Box 10631

Jackson, Mississippi 39209

WATER WELL DRILLERS LOG

CODED

T 19
Yazoo
9-3-85

Sept. 3 1985

K.M. Bud Cresswell

Yazoo

date well completed

firm name

county well located

LANDOWNER:

Paeco Drilling Co.

Natchez, Ms.

(mailing address)

description of formations encountered

from

to

Surface	0	60
blue clay	60	260
sand	260	290
shales	290	380
sand	380	480

WELL LOCATION:

sec. 18 T 10 N R 1 E
10 miles South of Natchez

WELL PURPOSE: Industrial
(home, irrigation, municipal, industrial)

CODED

WELL COMPLETION DATA:

- (1) diameter (inches) 3
- (2) total depth (feet) 480
- (3) static water level (feet) 120 below top of ground.
- (4) casing Steel 460 (material) (depth)
- (size) 3 If telescope see back.
- (5) screen 20 440 (length) (depth to top)
- (size) 3 (material) stainless
- (6) pump Air Compressor (HP) (yield gpm)
- (type power)
- (7) electric log No (yes or no)

(organization running log)

(8) how well bottom plugged Backwash

DRILLERS REMARKS:


RECEIVED

SEP 17 1985

Department of Natural Resources
Bureau of Land & Water Resources

If well telescopes please sketch and show depths.

GROUND LEVEL

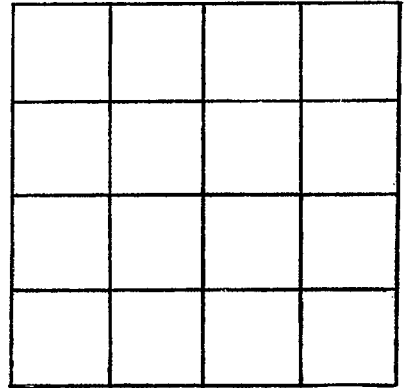

SECTION _____

Please indicate well location X.

ADDITIONAL INFORMATION

If more than one screen, show locations of each on sketch.