

Yazoo
T 20
10-1-69

MISSISSIPPI
BOARD OF WATER COMMISSIONERS
416 North State Street
Jackson, Mississippi 39201

WATER WELL DRILLERS LOG

CODED

10-1 19 David Berry firm name Yazoo county well located

LANDOWNER:	description of formations encountered	from	to
<u>Coker, Claude</u>			
<u>Benton, Miss.</u> (mailing address)	<u>clay</u>	<u>0</u>	<u>34</u>
	<u>fine sand & clay</u>	<u>34</u>	<u>65</u>
	<u>clay</u>	<u>65</u>	<u>329</u>
WELL LOCATION:	<u>Moody Branch sand</u>	<u>329</u>	<u>339</u>
sec. <u>9</u> T- <u>10</u> <u>N</u> R- <u>2</u> <u>E</u>	<u>sand with shale</u>	<u>339</u>	<u>370</u>
<u>10</u> miles <u>S</u> of <u>Benton</u>	<u>sand</u>	<u>370</u>	<u>400</u>
(distance) (direction) (nearest town)	<u>sand with break</u>	<u>400</u>	<u>462</u>
WELL PURPOSE:	<u>shale with fine sand</u>	<u>462</u>	<u>492</u>
(home, irrigation, municipal, industrial)	<u>fine sand with clay</u>	<u>492</u>	<u>523</u>
WELL COMPLETION DATA:	<u>shale</u>	<u>523</u>	<u>584</u>
(1) diameter (inches) <u>2"</u>	<u>shale with fine sand</u>	<u>584</u>	<u>615</u>
(2) total depth (feet) <u>706</u>	<u>shale</u>	<u>615</u>	<u>645</u>
(3) static water level (feet) <u>220</u> below top of ground.	<u>shale</u>	<u>645</u>	<u>670</u>
(4) casing <u>galv.</u> (material), <u>696</u> (depth)	<u>sand</u>	<u>670</u>	<u>706</u>
(size) if telescope see back.			
(5) screen <u>10 ft.</u> (length), <u>696</u> (depth to top)			
<u>2"</u> (size), <u>Stainless</u> (material)			
(6) pump <u>3 H.P. Air Comp.</u> (HP), (yield gpm)			
<u>elec.</u> (type power)			
(7) electric log (yes or no)			
(organization running log)			
(8) how well bottom plugged			


FEB 24 1970

MISSISSIPPI BOARD OF WATER COMMISSIONERS

DRILLERS REMARKS:

If well telescopes please sketch and show depths.

GROUND LEVEL

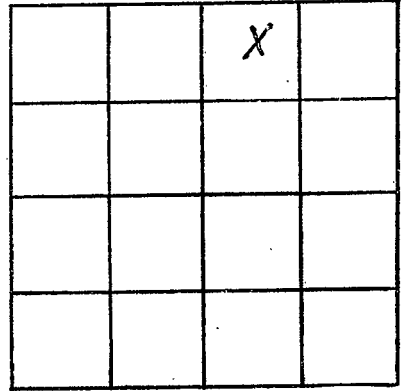

SECTION _____

Please indicate well location X.

ADDITIONAL INFORMATION

If more than one screen, show locations of each on sketch.