

Yazoo Co
T 21
2-20-70

MISSISSIPPI
BOARD OF WATER COMMISSIONERS
416 North State Street
Jackson, Mississippi 39201

WATER WELL DRILLERS LOG

Feb. 20 1970 Sud Cresswell Yazoo
date well completed firm name county well located

LANDOWNER:
Scotland Baptist Church
(mailing address)

description of formations encountered	from	to
	Clay	0
Blue clay	40	280
Sand	280	380

WELL LOCATION:
sec. 19 T 100 N R 1 E 150
10 miles EAST of Serrano
(distance) (direction) (nearest town)

WELL PURPOSE: DOMESTIC
(home, irrigation, municipal, industrial)

- WELL COMPLETION DATA:
- (1) diameter (inches) 2
 - (2) total depth (feet) 380
 - (3) static water level (feet) 80 below top of ground.
 - (4) casing 94/4, 360
(material) (depth)
2 (size) if telescope see back.
 - (5) screen 20, 360
(length) (depth to top)
2, Stainless
(size) (material)
 - (6) pump (HP) (yield gpm)
(type power)
 - (7) electric log (yes or no)
(organization running log)
 - (8) how well bottom plugged


APR 24 1970

DRILLERS REMARKS:

MISS. BD. OF
WATER COMM.

If well telescopes please
sketch and show depths.

GROUND LEVEL

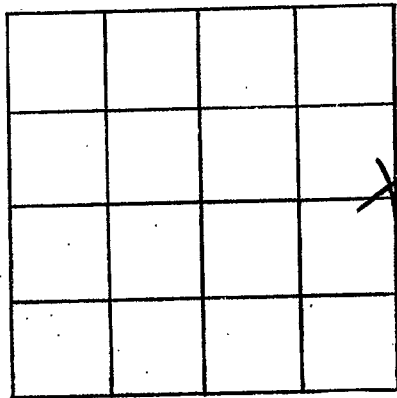

SECTION _____

Please indicate well location X.

ADDITIONAL INFORMATION

If more than one screen,
show locations of each on sketch.