

~~YAZOO~~  
 YAZOO  
 T 2000  
 12-11-80

MISSISSIPPI  
 BOARD OF WATER COMMISSIONERS  
 416 North State Street  
 Jackson, Mississippi 39201

WATER WELL DRILLERS LOG

Dec. 16 1980 E.M. "Bud" Cresswell Yazoo  
 date well completed firm name county well located

LANDOWNER:  
JACK Landown  
BENTONIA MS.  
 (mailing address)

description of formations encountered	from	to
<u>Clay</u>	<u>0</u>	<u>25</u>
<u>SAND-GRAVEL</u>	<u>25</u>	<u>50</u>

WELL LOCATION:  
 sec. 20 T. 10 N. R. 1 E  
10 miles EAST of BENTONIA  
 (distance) (direction) (nearest town)

WELL PURPOSE: FARM  
 (home, irrigation, municipal, industrial)


WELL COMPLETION DATA:  
 (1) diameter (inches) 2  
 (2) total depth (feet) 50  
 (3) static water level (feet) 20 below top of ground.  
 (4) casing PVC 40  
 (material) (depth)  
2 If telescope see back.  
 (size)  
 (5) screen 10 40  
 (length) (depth to top)  
2 PVC  
 (size) (material)  
 (6) pump 20  
 (HP) (yield gpm)  
 (type power)  
 (7) electric log no  
 (yes or no)  
 (organization running log)

(8) how well bottom plugged?  
SAND SHARP  
 DRILLERS REMARKS:

DEPT. OF NATURAL RESOURCES  
 BUREAU OF LAND & WATER RESOURCES  
 DEC 20 1980  
 RECEIVED

If well telescopes please sketch and show depths.

GROUND LEVEL

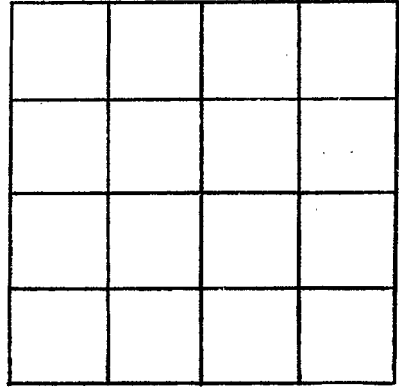

SECTION \_\_\_\_\_

Please indicate well location X.

ADDITIONAL INFORMATION

If more than one screen,  
show locations of each on sketch.