

MISSISSIPPI
BOARD OF WATER COMMISSIONERS
416 North State Street
Jackson, Mississippi 39201

CODED

WATER WELL DRILLERS LOG

Yazoo
U12
4-67
Elec Log
9-28

19 67 Bud Cresswell Yazoo
date well completed firm name county well located

LANDOWNER:

Carroll Potter

description of formations encountered

from to

Clay	0	80
Sand	80	100
lime - gumbo	100	150
Shale	150	350
Yazoo Clay	350	465
Wabigoon Shale	465	900
Sand - streaks shale	900	1090
Sand	1090	1151

(mailing address)

WELL LOCATION:

NE, NW, SE

sec 35 T 9 N R 4 E
S
1/2 miles West of Phenix
(distance) (direction) (nearest town)


WELL PURPOSE:

domestic
(home, irrigation, municipal, industrial)

WELL COMPLETION DATA:

- (1) diameter (inches) 4 X 2
- (2) total depth (feet) 1151
- (3) static water level (feet) 245 below top of ground.
- (4) casing Steel, 1121,
(material) (depth)
4 X 2 if telescope see back.
(size)
- (5) screen 30, 1121
(length) (depth to top)
008, 5-5
(size) (material)
- (6) pump 1 1/2, 15
(HP) (yield gpm)
Elec
(type power)
- (7) electric log yes
(yes/or no)
State
(organization running log)
- (8) how well bottom plugged Drop
Plug

CODED

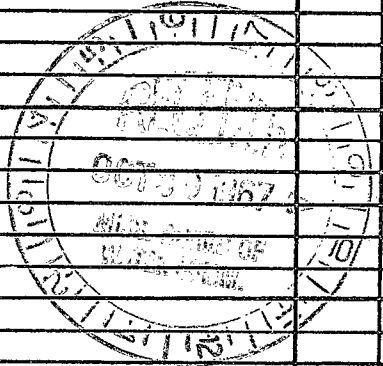

DRILLERS REMARKS:

If well telescopes please sketch and show depths.

GROUND LEVEL


4"
400'

2"
721'

30'
screen
DOB 55

If more than one screen,
show locations of each on sketch.

~~AZ~~

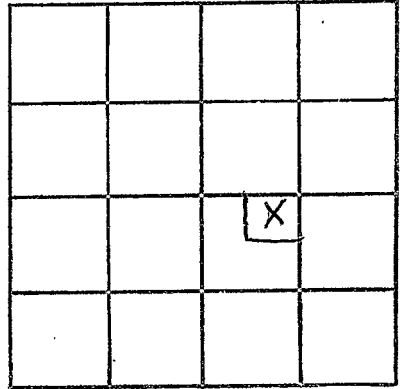

SECTION 35

Please indicate well location X.

ADDITIONAL INFORMATION

Lined area for additional information.