

Yazoo Co
U 14
2-15-70

MISSISSIPPI
 BOARD OF WATER COMMISSIONERS
 416 North State Street
 Jackson, Mississippi 39201

WATER WELL DRILLERS LOG

Feb 15 1970 Bud Cresswell Yazoo
 date well completed firm name county well located

LANDOWNER:

Tom Selby
 Rt. 2, Benton, Miss.
 (mailing address)

description of formations encountered

from to

Clay
 Sand-gravel
 0 60
 60 115

WELL LOCATION:

sec. 35 T 9 N R 4 E 150
 15 miles S.W. of B
 (distance) (direction) (nearest town)

WELL PURPOSE: Domestic
 (home, irrigation, municipal, industrial)

WELL COMPLETION DATA:

- (1) diameter (inches) 4
- (2) total depth (feet) 115
- (3) static water level (feet) 100 below top of ground.
- (4) casing 4 105
 (material) (depth)
 4 If telescope see back.
 (size)
- (5) screen 10 105
 (length) (depth to top)
 4" stainless
 (size) (material)
- (6) pump _____ (HP) _____ (yield gpm)
 _____ (type power)
- (7) electric log _____ (yes or no)
 _____ (organization running log)
- (8) how well bottom plugged _____


APR 24 1970

DRILLERS REMARKS:

MISS. BD. OF
 WATER COMMISSIONERS

If well telescopes please sketch and show depths.

GROUND LEVEL

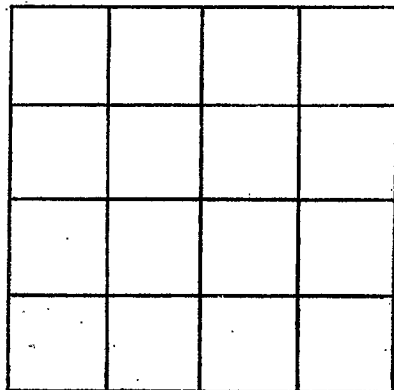

SECTION _____

Please indicate well location X.

ADDITIONAL INFORMATION

If more than one screen, show locations of each on sketch.