

Yazoo
U15
5-18-70

MISSISSIPPI
BOARD OF WATER COMMISSIONERS
416 North State Street
Jackson, Mississippi 39201

CODED

WATER WELL DRILLERS LOG

May 18 1970 date well completed
Luf Clemwell firm name
Yazoo county well located

LANDOWNER:

James L. McCoy
P.O. # 2
Benton, Miss.
(mailing address)

description of formations encountered

from to

clay 0 88
sand-gravel 80 115

WELL LOCATION:

sec 3 T 8 N R 4
2 miles South of Phoenix
(distance) (direction) (nearest town)

WELL PURPOSE: domestic
(home, irrigation, municipal, industrial)

WELL COMPLETION DATA:

- (1) diameter (inches) 2
- (2) total depth (feet) 115
- (3) static water level (feet) 85 below top of ground.
- (4) casing galv 105 (material) (depth)
2 (size) If telescope see back.
- (5) screen 10 105 (length) (depth to top)
2 (size) Stainless (material)
- (6) pump 1 1/2 85 GPM (HP) (yield gpm)
Elec (type power)
- (7) electric log NO (yes or no)

(organization running log)

(8) how well bottom plugged Pipe plug

DRILLERS REMARKS:


CODED

MAY 21 1970

MISS. BD. OF WATER COMM.

If well telescopes please sketch and show depths.

GROUND LEVEL

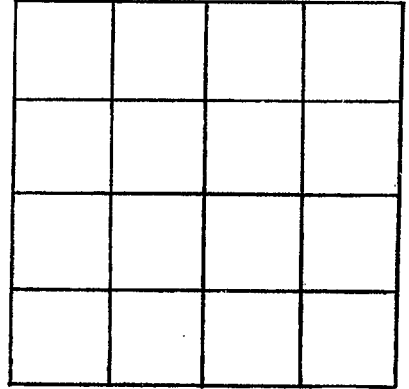

SECTION _____

Please indicate well location X.

ADDITIONAL INFORMATION

If more than one screen,
show locations of each on sketch.