

Yazoo
U16
6-6-70

MISSISSIPPI
BOARD OF WATER COMMISSIONERS
416 North State Street
Jackson, Mississippi 39201

CODED

WATER WELL DRILLERS LOG

6-6 1970 ^{Emp} Bud "Cresswell" Yazoo
date well completed firm name county well located

LANDOWNER:	description of formations encountered	from	to
Dave Catlin Jr. Redwood, Miss- (mailing address)	Gumbo SAND SAND-gravel	0 12 70	12 48 105
WELL LOCATION: sec. 24 T. 8N R. 4W 4 miles N.W. of Redwood (distance) (direction) (nearest town)			
WELL PURPOSE: Home (home, irrigation, municipal, industrial)			
WELL COMPLETION DATA:			
(1) diameter (inches) 2			
(2) total depth (feet) 105			
(3) static water level (feet) 20 below above top of ground.			
(4) casing Steel 100 (material) (depth)			
2 (size) if telescope see back.			
(5) screen 5 100 (length) (depth to top)			
2 Stainless (size) (material)			
(6) pump 0 0 (HP) (yield gpm)			
0 No pump (type power)			
(7) electric log NO (yes or no)			
0 (organization running log)			
(8) how well bottom plugged Steel plug			
DRILLERS REMARKS:			


CODED

JUN 23 1970

MISS. BD. OF
WATER COM.

If well telescopes please sketch and show depths.

GROUND LEVEL

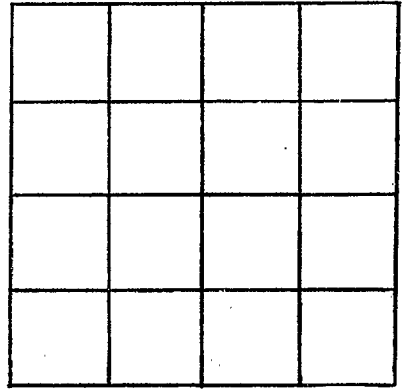

SECTION _____

Please indicate well location X.

ADDITIONAL INFORMATION

If more than one screen,
show locations of each on sketch.