

Yozzo
U 17
11/6/63

CODED

WATER WELL DRILLERS LOG *Yozzo*

Date: *11/16*, 19*63*, Driller: *Bailey Drilling Co.* County: *Washington*
(Name)


(1) Owner of Land:	Description & Color of Materials Sand, Clay, Red Clay, Shell, etc.	Thick- ness Feet	Depth Feet
<i>Fulton Camp</i> (Name) <i>Holly Bluff, Miss.</i> (Address)	<i>Clay</i> <i>Sand + gravel</i>		<i>90</i> <i>100</i>
(2) Location: $\frac{1}{4}$, $\frac{1}{4}$, Sec <i>6</i> <i>9N 4W</i> T R <i>17</i> miles <i>South</i> of <i>Holly Bluff</i> (distance) (direction) (Nearest Town)			
(3) Topography: <i>Flat</i> (Hilly) (Flat) (Level)			
(4) Purpose of Well: <i>Hunting Camp</i> (Domestic Irrigation, Municipal, Industrial, Other)			

Information upon completion of well:

- (1) Diameter *2* inches.
- (2) Total Depth *100* feet.
- (3) Water Level *28* feet below top of ground.
- (4) Cased to *all way*, Size *2*.
- (5) Screen: Size *2*, Length *5*.
- (6) Were any formations sealed against pollution?
_____ yes, no.

If YES depth of formation _____
Why _____
Drillers Remarks: _____

CODED

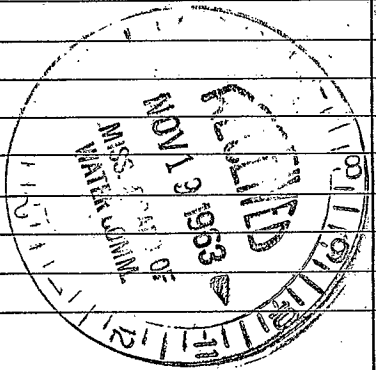

(Use Back Side)

Well No.

