

YAZOO

MISSISSIPPI BOARD OF WATER COMMISSIONERS

W21

WATER WELL DRILLERS LOG

CODED

4-63

Date: April, 1963, Driller: David Berry County YAZOO

4213 4572

(Name)

(1) Owner of Land: Jessie HINSON  
 (Name)  
Amwood, Miss  
 (Address) 617 8 4w

(2) Location: 1/4, 1/4, Sec. 31 T 9 R 9w  
1 miles N, of Wanna  
 (distance) (direction) (Nearest Town)  
County

(3) Topography: Flat  
 (Hilly) (Flat) (Level)

(4) Purpose of Well:  
 (Domestic Irrigation  
 Municipal, Industrial, Other)

Description & Color of Materials Sand, Clay, Red Clay, Shell, etc.	Thick- ness Feet	Depth Feet
<u>Kelly</u>		<u>21</u>
<u>Gravel</u>	<u>20</u>	<u>41</u>
<u>Gravel</u>	<u>22</u>	<u>63</u>
<u>SAND</u>	<u>22</u>	<u>85</u>
<u>SAND</u>	<u>21</u>	<u>106</u>
<u>SAND</u>	<u>22</u>	<u>128</u>
<u>Clay</u>	<u>13</u>	<u>141</u>

Information upon completion of well:

(1) Diameter 3 1/2 inches.

(2) Total Depth 141 feet.

(3) Water Level 28' feet below top of ground.

(4) Cased to 63, Size 3".

(5) Screen: Size 2, Length 21.


(6) Were any formations sealed against pollution?  
 \_\_\_\_\_ yes, \_\_\_\_\_ no.

CODED

If YES, depth of formation \_\_\_\_\_

Why \_\_\_\_\_

Drillers Remarks: \_\_\_\_\_

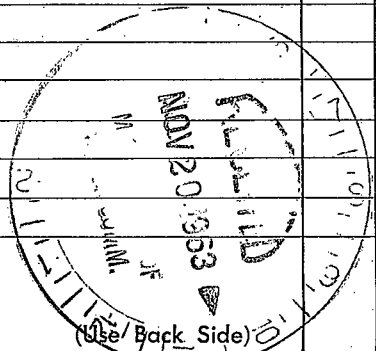

Well No.

1870

1871

1872

1873

1874

1875

1876

1877