

ELO 242

MISSISSIPPI
BOARD OF WATER COMMISSIONERS
416 North State Street
Jackson, Mississippi 39201

WATER WELL DRILLERS LOG

CODED

YAZOO
U 23
4-15-72

April 15 1972 date well completed
Jeffcoat Drilling Co. firm name
YAZOO county well located

LANDOWNER: Flod Johnson

Phonix Miss.

(mailing address)

description of formations encountered

from

to

Clay
Sand

0

74

74

100

Gravel

100

122

WELL LOCATION:

sec. 10 T 8N N R 4W E
S W
4 miles S/W of Phonix
(distance) (direction) (nearest town)

WELL PURPOSE: Home
(home, irrigation, municipal, industrial)

WELL COMPLETION DATA:

- (1) diameter (inches) 4"
- (2) total depth (feet) 119 ft
- (3) static water level (feet) 91 below above top of ground.
- (4) casing (material) (depth) (size) if telescope see back.
- (5) screen 10 ft 108 (length) (depth to top) #11 Plastic (size) (material)
- (6) pump 3/4 10 (HP) (yield gpm) (type power)
- (7) electric log Yes (yes or no)

Mississippi Geological Survey
(organization running log)

(8) how well bottom plugged xxx back wash vale

CODED


JUN - 9 1972

MISS. BD. OF
WATER COM.

DRILLERS REMARKS:

If well telescopes please
sketch and show depths.

GROUND LEVEL

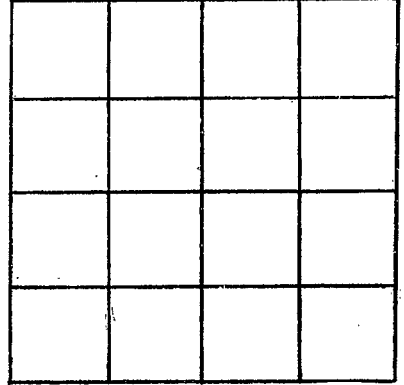

SECTION _____

Please indicate well location X.

ADDITIONAL INFORMATION

If more than one screen,
show locations of each on sketch.