

YAZOO
U 25
12-17-72

MISSISSIPPI
BOARD OF WATER COMMISSIONERS
416 North State Street
Jackson, Mississippi 39201

CODED

WATER WELL DRILLERS LOG


Dec. 17 1972 E.M. "Bud" Besswell Yazoo
date well completed firm name county well located

LANDOWNER:	description of formations encountered	from	to
J.V. Whitaker SARTIA, Miss. (mailing address)	Clay Sand - yellow Clay - blue	0 40 110	40 110 620
WELL LOCATION: sec. 9 T. 9 N R. 4 ON DUMP LAKE (distance) (direction) (nearest town)	Shale Sand	620 700	700 760
WELL PURPOSE: FARM (home, irrigation, municipal, industrial)			
WELL COMPLETION DATA:			
(1) diameter (inches) 4			
(2) total depth (feet) 760			
(3) static water level (feet) 0 below top of ground.			
(4) casing: Steel 720 (material) (depth) 4 if telescope see back. (size)			
(5) screen 40 720 (length) (depth to top) 2 STAINLESS (size) (material)			
(6) pump 2 50 (HP) (yield gpm) 2 (type power)			
(7) electric log No (yes or no) 0 (organization running log)			
(8) how well bottom plugged Steel plug			
DRILLERS REMARKS:			

JAN 10 1973

If well telescopes please sketch and show depths.

GROUND LEVEL

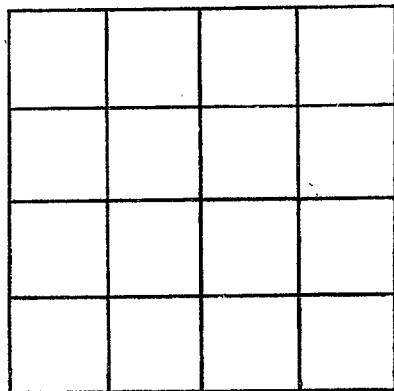

SECTION _____

Please indicate well location X.

ADDITIONAL INFORMATION

If more than one screen,
show locations of each on sketch.