

YAZOO  
 U28  
 Log # 254

MISSISSIPPI  
 BOARD OF WATER COMMISSIONERS  
 416 North State Street  
 Jackson, Mississippi 39201

CODED

WATER WELL DRILLERS LOG

July 19 1973 E.M. "Bud" Cresswell Yazoo  
 date well completed firm name county well located

LANDOWNER:  
 Pat Murphy  
 Sartoris, Min.  
 (mailing address)

description of formations encountered	from	to
Clay	0	25
Sand gravel	25	105
Clay	105	460
Sandy shale	460	680
Shale	680	745
Sand	745	800

WELL LOCATION:  
 sec. 9 T 9 N R. 4 E  
 5 miles S-W of Sartoris  
 (distance) (direction) (nearest town)

WELL PURPOSE: Home  
 (home, irrigation, municipal, industrial)

WELL COMPLETION DATA:

(1) diameter (inches) 2

(2) total depth (feet) 800

(3) static water level (feet) 0 below top of ground.

(4) casing Steel, 770 (material) (depth)  
 2 if telescope see back. (size)

(5) screen 30, 770 (length) (depth to top)  
 2, Stainless (size) (material)

(6) pump 1, 20 (HP) (yield gpm)  
 0 (type power)

(7) electric log yes (yes or no)  
 USGS (organization running log)

(8) how well bottom plugged  
 Pref plug


CODED

DRILLERS REMARKS:

AUG 7 1973

If well telescopes please  
sketch and show depths.

GROUND LEVEL

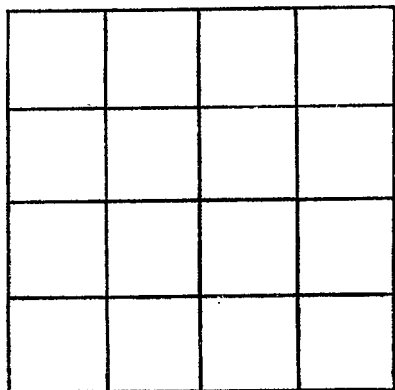

SECTION \_\_\_\_\_

Please indicate well location X.

ADDITIONAL INFORMATION

If more than one screen,  
show locations of each on sketch.