

COPIED

MISSISSIPPI
BOARD OF WATER COMMISSIONERS
416 North State Street
Jackson, Mississippi 39201

WATER WELL DRILLERS LOG

YAZOO
U29
7-9-73

June 9 1973 L.M. "Bud" Cresswell Yazoo
date well completed firm name county well located

LANDOWNER:
J. W. Harris
Satartia, Miss.
(mailing address)

description of formations encountered	from	to
Clay	0	30
Sand - gravel	30	210
Clay	210	520
Shale	520	600
Bed	600	640

WELL LOCATION:
sec. 10 T. 9 N. R. 4 E
4 miles S-W of Satartia
(distance) (direction) (nearest town)

WELL PURPOSE: Farm
(home, irrigation, municipal, industrial)

- WELL COMPLETION DATA:
- (1) diameter (inches) 2
 - (2) total depth (feet) 640
 - (3) static water level (feet) 0 below above top of ground.
 - (4) casing steel, 620, (material) (depth)
2 if telescope see back. (size)
 - (5) screen 20, 620 (length) (depth to top)
2, stainless (size) (material)
 - (6) pump 3/4, 15 (HP) (yield gpm)
0 (type power)
 - (7) electric log No (yes or no)
0 (organization running log)
 - (8) how well bottom plugged Steel plug


COPIED

DRILLERS REMARKS:

AUG 7 1973

If well telescopes please
sketch and show depths.

GROUND LEVEL

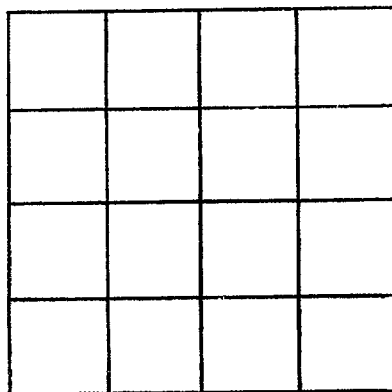

SECTION _____

Please indicate well location X.

ADDITIONAL INFORMATION

If more than one screen,
show locations of each on sketch.