

YAZOO
U30
11-9-73

MISSISSIPPI
BOARD OF WATER COMMISSIONERS
416 North State Street
Jackson, Mississippi 39201

CODED

WATER WELL DRILLERS LOG

Nov. 9 1973 R.M. "Bud" Casswell Yazoo
date well completed firm name county well located

LANDOWNER:

LAWRENCE W. LONG - M.D.
SARTARTIA, Miss.
(mailing address)

description of formations encountered

from

to

CLAY
SAND & GRAVEL 0 15
15 89

WELL LOCATION:

sec. 22 T 9 N R 4 E
1 miles S of Dump Lake
(distance) (direction) (nearest town)

WELL PURPOSE: Home
(home, irrigation, municipal, industrial)

WELL COMPLETION DATA:

- (1) diameter (inches) 2
(2) total depth (feet) 89
(3) static water level (feet) 15 below top of ground.
(4) casing Steel 84
(material) (depth)
2 (size) if telescope see back.
(5) screen 5 84
(length) (depth to top)
2 Stainless
(size) (material)
(6) pump 1/3 5
(HP) (yield gpm)
0
(type power)
(7) electric log No
(yes or no)
0
(organization running log)

CODED

(8) how well bottom plugged
Steel plug


DRILLERS REMARKS:

NOV 13 1973

MISSISSIPPI
BOARD OF WATER COMMISSIONERS

If well telescopes please sketch and show depths.

GROUND LEVEL

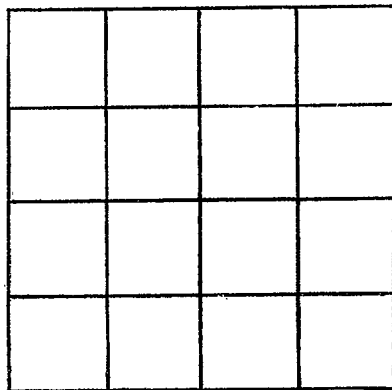

SECTION _____

Please indicate well location X.

ADDITIONAL INFORMATION

If more than one screen,
show locations of each on sketch.