

YAZOO
U 31
12-28-73

MISSISSIPPI
 BOARD OF WATER COMMISSIONERS
 416 North State Street
 Jackson, Mississippi 39201

CODED

WATER WELL DRILLERS LOG

Nov. 28, 1973 date well completed E.M. "Bud" CRESSWELL firm name YAZOO county well located

LANDOWNER:	description of formations encountered	from	to
<u>YAZOO COUNTY Schools</u> <u>YAZOO City, Miss.</u> (mailing address)	<u>CLAY</u>	<u>0</u>	<u>30</u>
WELL LOCATION: sec. <u>16</u> T. <u>9</u> N. R. <u>4</u> W. <u>5</u> miles <u>5</u> of <u>SATARTIA</u> (distance) (direction) (nearest town)	<u>SAND GRAVEL</u>	<u>30</u>	<u>89</u>
WELL PURPOSE: <u>Home</u> (home, irrigation, municipal, industrial)			
WELL COMPLETION DATA:			
(1) diameter (inches) <u>2</u>			
(2) total depth (feet) <u>89</u>			
(3) static water level (feet) <u>15</u> below top of ground.			
(4) casing <u>Steel</u> , <u>84</u> (material) (depth)			
<u>2</u> if telescope see back. (size)			
(5) screen <u>5</u> , <u>84</u> (length) (depth to top)			
<u>2</u> , <u>STAINLESS</u> (size) (material)			
(6) pump <u>3/4</u> , <u>10</u> (HP) (yield gpm)			
<u>0</u> (type power)			
(7) electric log <u>No</u> (yes or no)			
<u>0</u> (organization running log)			
(8) how well bottom plugged <u>Steel plug</u>			
DRILLERS REMARKS:			


CODED

DEC 2 1973
 JAN 2 1974

MISS. BO. OF WATER COMM.

If well telescopes please
sketch and show depths.

GROUND LEVEL

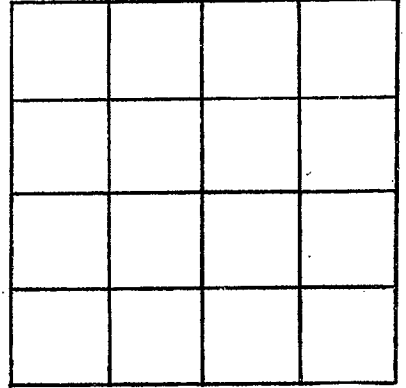

SECTION _____

Please indicate well location X.

ADDITIONAL INFORMATION

If more than one screen,
show locations of each on sketch.