

YAZOO  
 U32  
 1-7-74

MISSISSIPPI  
 BOARD OF WATER COMMISSIONERS  
 416 North State Street  
 Jackson, Mississippi 39201

CODED

WATER WELL DRILLERS LOG

JAN. 7 1974 E.M. "Bud" CRESSWELL Yazoo  
 date well completed firm name county well located


| LANDOWNER:                                                                                                    | description of formations encountered | from | to |
|---------------------------------------------------------------------------------------------------------------|---------------------------------------|------|----|
| VERNON WHITAKER                                                                                               | CLAU                                  | 0    | 18 |
| SATARTIA, Miss.<br>(mailing address)                                                                          | SAND-GRAVEL                           | 18   | 89 |
| WELL LOCATION:<br>sec. 11 T. 9 N R. 4 W<br>4 miles South of SATARTIA<br>(distance) (direction) (nearest town) |                                       |      | 1  |
| WELL PURPOSE: Home<br>(home, irrigation, municipal, industrial)                                               |                                       |      |    |
| WELL COMPLETION DATA:                                                                                         |                                       |      |    |
| (1) diameter (inches) 2                                                                                       |                                       |      |    |
| (2) total depth (feet) 89                                                                                     |                                       |      |    |
| (3) static water level (feet) 12 below top of ground.                                                         |                                       |      |    |
| (4) casing Steel, 84<br>(material) (depth)                                                                    |                                       |      |    |
| 2 if telescope see back.<br>(size)                                                                            |                                       |      |    |
| (5) screen 5, 84<br>(length) (depth to top)                                                                   |                                       |      |    |
| 2 STAINLESS<br>(size) (material)                                                                              |                                       |      |    |
| (6) pump None 0<br>(HP) (yield gpm)                                                                           |                                       |      |    |
| 0<br>(type power)                                                                                             |                                       |      |    |
| (7) electric log No<br>(yes or no)                                                                            |                                       |      |    |
| 0<br>(organization running log)                                                                               |                                       |      |    |
| (8) how well bottom plugged<br>Steel plug                                                                     |                                       |      |    |
| DRILLERS REMARKS:                                                                                             |                                       |      |    |

CODED

JAN 28 1974

If well telescopes please sketch and show depths.

GROUND LEVEL

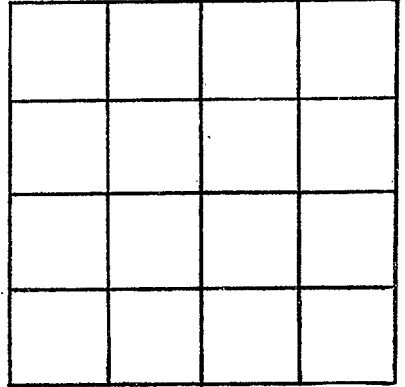

SECTION \_\_\_\_\_

Please indicate well location X.

ADDITIONAL INFORMATION

If more than one screen,  
show locations of each on sketch.