

YAZOO
 W 33
 7-16-74

MISSISSIPPI
 BOARD OF WATER COMMISSIONERS
 416 North State Street
 Jackson, Mississippi 39201 **CODED**

WATER WELL DRILLERS LOG

July 16 1974 E.M. "Bud" CRESSWELL Yazoo
 date well completed firm name county well located

LANDOWNER:
 Thomas R. Strickler
 Satastia, Miss.
 (mailing address)

description of formations encountered	from	to
clay	0	40
sand	40	70
clay	70	485
shale streaks sand	485	640
sand	640	760

WELL LOCATION:
 sec. 23 T 9 N R 4 E
 3 miles South of Satastia
 (distance) (direction) (nearest town)

WELL PURPOSE: Farm
 (home, irrigation, municipal, industrial)

WELL COMPLETION DATA:

(1) diameter (inches) 4

(2) total depth (feet) 760

(3) static water level (feet) 15 below top of ground.

(4) casing steel, 720 (material), (depth)
 4 (size) if telescope see back.

(5) screen 40 720 (length), (depth to top)
 2, stainless (size), (material)

(6) pump 3 40 (HP), (yield gpm)
 0 (type power)

(7) electric log No (yes or no)
 0 (organization running log)

(8) how well bottom plugged
 steel plug

CODED


DRILLERS REMARKS:

RECEIVED
 AUG 25 1974

MISS. BD. OF WATER COMMISSIONERS

If well telescopes please
sketch and show depths.

GROUND LEVEL

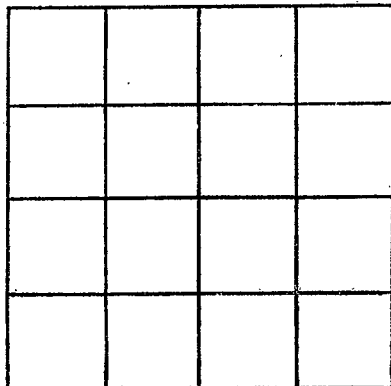

SECTION _____

Please indicate well location X.

ADDITIONAL INFORMATION

If more than one screen,
show locations of each on sketch.