

YAZOO
 LL34
 12174
 E Loc #261

MISSISSIPPI
 BOARD OF WATER COMMISSIONERS
 416 North State Street
 Jackson, Mississippi 39201

CODED

WATER WELL DRILLERS LOG

December 1974 H RIVER DRILLING SERVICE YAZOO
 date well completed firm name county well located

LANDOWNER: SHELL OIL
 COMPANY - Leasing
 H+P DRILLING CO.
 (mailing address)

WELL LOCATION: SE 1/4 NW 1/4 SW 1/4
 sec. 1 T 8 N R 4 E
 S W
 (distance) miles of (direction) (nearest town)

WELL PURPOSE: oil well supply
 (home, irrigation, municipal, industrial)

- WELL COMPLETION DATA:
- (1) diameter (inches) 6' x 4'
 - (2) total depth (feet) 1276
 - (3) static water level (feet) 297 above top of ground.
 - (4) casing B.F. 1216 (material) (depth) 6" - 480 ft. If telescope see back.
 (size) 4" - 136 ft.
 - (5) screen 40 1216 (length) (depth to top) 4" 304 S.S. (size) (material)
 - (6) pump 15 150 (HP) (yield gpm)
 Elect. - Generator (type power)
 - (7) electric log Yes (yes or no)
 MISS. Geol. Survey (organization running log)
 - (8) how well bottom plugged Back
 WATER VALUE

description of formations encountered	from	to
TO P. SOIL + SAND	0	3
SAND	3	12
CLAY	12	64
SAND	64	122
CLAY AND SAND STREAKS	122	268
SAND	268	294
CLAY	294	900
SAND	900	920
CLAY AND THIN SAND STR.	920	1160
SAND	1160	1240
CLAY	1240	1258
SAND	1258	1277
CLAY + Rocks	1277	1416

CODED

INDICATED IN
 RECORD BOOK

JAN 2 1975

MISS. BD. OF WATER COMM


480 ft of 6 inch casing
 736 ft of 4 inch casing
 20' - 4" - Screen → 1216 - 1236
 20' - 4" - BLANK → 1236 - 1256
 20' - 4" - Screen → 1256 - 1276

DRILLERS REMARKS:

4

If well telescopes please sketch and show depths.

GROUND LEVEL

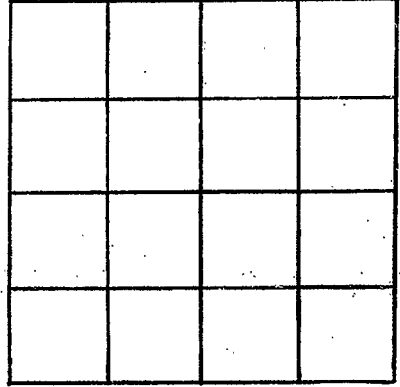

SECTION _____

Please indicate well location X.

ADDITIONAL INFORMATION

A series of horizontal lines for recording additional information, starting below the 'ADDITIONAL INFORMATION' header and extending to the bottom of the page.

If more than one screen, show locations of each on sketch.