

Yazoo  
 2135  
 7-31-75

MISSISSIPPI  
 BOARD OF WATER COMMISSIONERS  
 416 North State Street  
 Jackson, Mississippi 39201

CODED

WATER WELL DRILLERS LOG


July 31 1975 E.M. "Bud" CRESSWELL Yazoo  
 date well completed firm name county well located

LANDOWNER:	description of formations encountered	from	to
J.U. Whitaker SARTORIA, MS. (mailing address)			
<b>WELL LOCATION:</b>			
sec 23 T 9 N R 5 W 15 J 10 miles South of Sartoria (distance) (direction) (nearest town)			
<b>WELL PURPOSE:</b> Farm (home, irrigation, municipal, industrial)			
<b>WELL COMPLETION DATA:</b>			
(1) diameter (inches) 2			
(2) total depth (feet) 89			
(3) static water level (feet) 16 below top of ground.			
(4) casing Steel 84 (material) (depth)			
2 (size) If telescope see back.			
(5) screen 5 84 (length) (depth to top)			
2 Stainless (size) (material)			
(6) pump 3/4 10 (HP) (yield gpm)			
0 (type power)			
(7) electric log no (yes or no)			
0 (organization running log)			
(8) how well bottom plugged Steel plug			
DRILLERS REMARKS:			

RECEIVED  
 AUG 29 1975

If well telescopes please sketch and show depths.

**GROUND LEVEL**

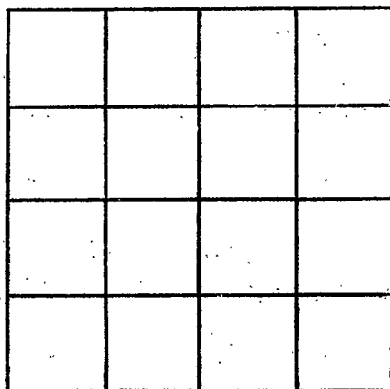

SECTION \_\_\_\_\_

Please indicate well location X.

**ADDITIONAL INFORMATION**

If more than one screen,  
show locations of each on sketch.