

YAZOO  
 U36  
 3-12-77  
 E Log # 272

MISSISSIPPI  
 BOARD OF WATER COMMISSIONERS  
 416 North State Street  
 Jackson, Mississippi 39201

CODED

WATER WELL DRILLERS LOG

MARCH 12 1977 F.M. "Bud" CRESSWELL Yazoo  
 date well completed firm name county well located


LANDOWNER:	description of formations encountered	from	to
Dudley Pillow Yazoo City, MS. (mailing address)			
WELL LOCATION: sec. 14 T 9 N R 4 E 3 S 5 W (distance) miles (direction) of (nearest town)			
WELL PURPOSE: Farm (home, irrigation, municipal, industrial)			
WELL COMPLETION DATA:			
(1) diameter (inches) 4			
(2) total depth (feet) 760			
(3) static water level (feet) 6 below top of ground.			
(4) casing Steel 740 (material) (depth)			
4 (size) if telescope see back.			
(5) screen 20 740 (length) (depth to top)			
2 Stainless (size) (material)			
(6) pump 1 1/2 50 (HP) (yield gpm)			
0 (type power)			
(7) electric log Yes (yes or no)			
State (organization running log)			
(8) how well bottom plugged Not plugged			
DRILLERS REMARKS:			

RECEIVED  
 APR 12 1977

MISS. BD. OF WATER COMM.

If well telescopes please sketch and show depths.

GROUND LEVEL

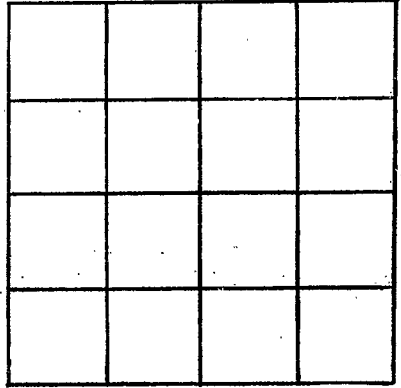

SECTION \_\_\_\_\_

Please indicate well location X.

ADDITIONAL INFORMATION

If more than one screen, show locations of each on sketch.