

YAZOO
U37
3-28-77
E Log #273

MISSISSIPPI
 BOARD OF WATER COMMISSIONERS CODED
 416 North State Street
 Jackson, Mississippi 39201

WATER WELL DRILLERS LOG

March 28 1977 E. M. "Bud" Cresswell Yazoo
 date well completed firm name county well located

LANDOWNER:	description of formations encountered	from	to
<u>Dixie Farms</u>	<u>Clay</u>	<u>0</u>	<u>32</u>
<u>Sartoria, Ms.</u>	<u>Part gravel</u>	<u>30</u>	<u>105</u>
(mailing address)	<u>Clay</u>	<u>105</u>	<u>440</u>
WELL LOCATION:	<u>Shale</u>	<u>420</u>	<u>640</u>
sec. <u>6</u> T <u>9</u> N R. <u>40</u> E	<u>Sand</u>	<u>640</u>	<u>780</u>
<u>4</u> miles <u>SW</u> of <u>Sartoria</u> (distance) (direction) (nearest town)			
WELL PURPOSE: <u>Farm</u> (home, irrigation, municipal, industrial)			
WELL COMPLETION DATA:			
(1) diameter (inches) <u>4</u>			
(2) total depth (feet) <u>780</u>			
(3) static water level (feet) <u>0</u> below top of ground. above			
(4) casing <u>Steel</u> <u>760</u> (material) (depth)			
<u>4</u> if telescope see back. (size)			
(5) screen <u>20ft.</u> <u>760</u> (length) (depth to top)			
<u>2</u> <u>Standard steel</u> (size) (material)			
(6) pump <u>1 1/2</u> <u>30</u> (HP) (yield gpm)			
<u>0</u> (type power)			
(7) electric log <u>yes</u> (yes or no)			
<u>State</u> (organization running log)			
(8) how well bottom plugged <u>Steel plug</u>			
DRILLERS REMARKS:			


CODED

RECEIVED
 APR 12 1977

MISS. BD. OF WATER COMMISSIONERS

If well telescopes please sketch and show depths.

GROUND LEVEL

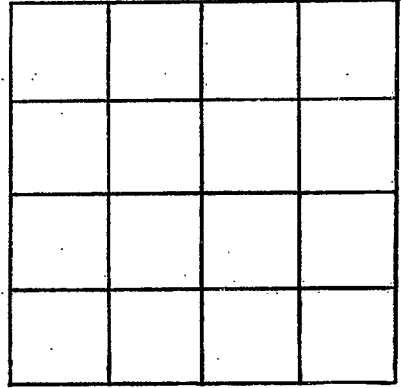

SECTION _____

Please indicate well location X.

ADDITIONAL INFORMATION

If more than one screen, show locations of each on sketch.