

NE/4 -

SE/4 -

SE/4

YU300

1U50

12-66

Elec. Log

MISSISSIPPI
 BOARD OF WATER COMMISSIONERS
 416 North State Street
 Jackson, Mississippi 39201

WATER WELL DRILLERS LOG

12-18-66 19

Bud CRESSWELL

Y4200

date well completed

firm name

county well located

LANDOWNER:

Mrs. J. L. Davidson

description of formations encountered

from

to

JARTARTIA

(mailing address)

sand-gravel

0 120

yellow clay

120 580

shaly shale

580 735

gray sand-fine

735 780

red shale

780 840

hard shale - streaks sand

840 1300

sand fine

1300 1400

shale

1400 1475

sand

1475 1520

hard shale

1520 1575

coarse sand

1575 1675


WELL LOCATION:

sec 31 T 9 N R 4 E
 S W
 10 miles South of JARTARTIA
 (distance) (direction) (nearest town)

WELL PURPOSE: Domestic (home, irrigation, municipal, industrial)

WELL COMPLETION DATA:

- (1) diameter (inches) 4 x 2
- (2) total depth (feet) 1645
- (3) static water level (feet) 6 below top of ground.
- (4) casing Steel (material) 147 (depth), 4 (size) if telescope see back.
- (5) screen 30 (length) 1615 (depth to top), 2" Stainless steel (size) (material)
- (6) pump 1/2 (HP) 25 (yield gpm), 220 (type power)
- (7) electric log Yes (yes or no), U.S.G.S. (organization running log)
- (8) how well bottom plugged casing

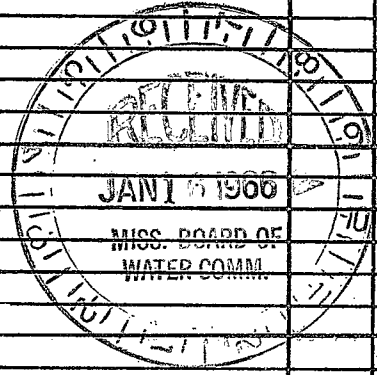

DRILLERS REMARKS:

If well telescopes please sketch and show depths.

GROUND LEVEL

			X

SECTION 31

Please indicate well location X.

ADDITIONAL INFORMATION

If more than one screen, show locations of each on sketch.